

1271
1996 PRESQUE ISLE COUNTY, STATE OF MICHIGAN REMONUMENTATION

LAND CORNER RECORDATION CERTIFICATE
Filing Requirement of Act 74, Mich. P.A. 1970

LIBER 319 PAGE 118

For corners in

Presque Isle
(County)

Located In:

Corner Code #

1. Public Land Survey

T 34 N R 5 E

G-3

T R

T R

T R

T R

2. Property Controlling
in Section

S

T R

S

T R

3. Miscellaneous
Property in Sec.

S

T R

S

T R

PRESQUE ISLE COUNTY
RECORDED

96 JUL 12 AM 11:39

Janet M. Scomb
REGISTER OF DEEDS

Register of Deeds Stamp & File Number

4. Lot No. _____, Recorded Plat _____

5. Private Claims _____

I, James A. Beck, in a field survey on Feb 22, 1996 do hereby state that under requirements of P.A. 74, Michigan P.A. of 1970, the corner points mentioned in lines 1 and 2 above were in conformance with regulations and rules therefore as required in the current manual of survey instructions of the United States Department of the Interior, Bureau of Land Management or by a decree of a Court of Law and/or that the corner points mentioned in lines 3, 4 and 5 above were in conformance with the rules of the Michigan Board of Land Surveyors or by a Decree of a Court of Law; established, re-established, monumented, recovered, found as expressed below:

NOTE: Not more than 2 corners, all in the same town and range, may be recorded on this certificate.

	A	B	C	D	E	F	G	H	I	J	K	L	M
1													
2		6		5		4		3		2		1	
3													
4		7		8		9		10		11		12	
5													
6		18		17		16		15		14		13	
7													
8		19		20		21		22		23		24	
9													
10		30		29		28		27		26		25	
11													
12		31		32		33		34		35		36	
13													

A. Description of original monument and accessories and/or subsequent restoration:

G-3

G.L.O. 1856
Alfred Millerd

"set post Corner of Secs. 3,4,9 & 10"
Hemlock 24 S32W 24

B. Ash 6 N15E 42

Sep. 25, 1972
P.A. 74 Recordation
by R.E. Alanen
Reg. No. 12042

1/2" steel
15" Elm N41°00'E 53.05 (nail)
8" Poplar S 67°30'W 50.40 (nail)
12" Elm S47°15'E 60.45 (nail)

Sep. 18, 1978
P.A. 74 Recordation
by Ronald Bischer
Reg No. 22428
fd. 1/2" rod
Witnesses
S33°W 32.05' 3" Cedar
S09°E 43.68' 5" Cedar
S 50°E 51.32' 4" Cedar

Nov. 9, 1979
P.A. 74 Recordation
by Delmer Porter
Reg. No. 15410
Conc. Mon./Brass Cap
Witnesses:
S50°E 51.32' 4" Cedar
S09°E 43.68' 5" Cedar
S33°W 32.05' 3" Cedar

B. Description of corner evidence found and/or method applied in restoring or reestablishing corner:

G-3

1996 Remonumentation
by James A. Beck

Found cement monument
with brass cap

Corner falls at centerline East-West gravel road, 5'+or- Easterly
of old fence South extended and at woods-field line to North

witnesses found:
S 33°W 32.05' 9" Cedar
S 50°E 51.32' 9" Cedar

Ratified by Peer Group

in accordance with P.A. 345

Chairman *Delmer Porter*

Date 5/22/96

C. Description of monument for corner and accessories established to perpetuate locating the position of the corner:


G-3

1996 Remonumentation
by James A. Beck

cement monument
with brass cap

Corner falls at centerline East-West gravel road, 5'+or- Easterly
of old fence South extended and at woods-field line to North

witnesses:
S 33°W 32.05' 21559 tag in 9" Cedar
S 50°E 51.32' 21559 tag in 9" Cedar
N 46°E 45.52' 21559 tag in 4" Cedar
S 21°E 75.26' 21559 tag in 11" Cedar used as
anchor for cable gate

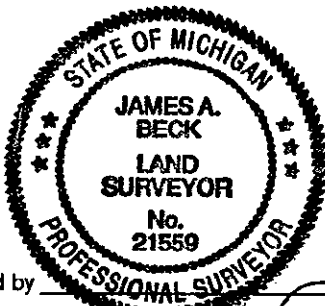

Signed by *James A. Beck*

Date June 17, 1996

Surveyor's Michigan License No. 21559