

# 1996 PRESQUE ISLE COUNTY, STATE OF MICHIGAN REMONUMENTATION

## LAND CORNER RECORDATION CERTIFICATE Filing Requirement of Act 74, Mich. P.A. 1970

LIBER 319 PAGE 120

For corners in

Presque Isle  
(County)

Located In:

Corner Code #

1. Public Land Survey

T 34N 5E G5  
T    R      
T    R      
T    R      
S    T    R      
S    T    R      
S    T    R      
S    T    R    

2. Property Controlling  
in Section

3. Miscellaneous  
Property in Sec.

PRESQUE ISLE COUNTY  
RECORDED

96 JUL 12 AM 11:40

*Janet M. Slamb*  
REGISTER OF DEEDS

Register of Deeds Stamp & File Number

4. Lot No.       , Recorded Plat         
5. Private Claims       

I, James A. Beck, in a field survey on May 3, 1996 do hereby state that under requirements of P.A. 74, Michigan P.A. of 1970, the corner points mentioned in lines 1 and 2 above were in conformance with regulations and rules therefore as required in the current manual of survey instructions of the United States Department of the Interior, Bureau of Land Management or by a decree of a Court of Law and/or that the corner points mentioned in lines 3, 4 and 5 above were in conformance with the rules of the Michigan Board of Land Surveyors or by a Decree of a Court of Law; established, re-established, monumented, recovered, found as expressed below:

NOTE: Not more than 2 corners, all in the same town and range, may be recorded on this certificate.

	A	B	C	D	E	F	G	H	I	J	K	L	M
1													
2	6		5		4		3		2		1		
3													
4	7		8		9		10		11		12		
5							⊕						
6	18		17		16		15		14		13		
7													
8	19		20		21		22		23		24		
9													
10	30		29		28		27		26		25		
11													
12	31		32		33		34		35		36		
13													

A. Description of original monument and accessories and/or subsequent restoration:

G-5  
G.L.O. 1856  
Alfred Millerd  
" Set post Corner Secs 9,10,15 & 16  
Cedar 9 N 82°W 27  
Cedar 8 S54°E 7 "

May 14, 1979  
P.A. 74 Recordation  
by Jerry Wilcox  
Reg. No. 14102  
" Set rerod with cap by double proportion"  
Witnesses:  
S 60°E 3" B.Ash 9.85'  
S 55°W 9" Cedar 9.75'  
N 20°E, 8" Cedar 15.21'

B. Description of corner evidence found and/or method applied in restoring or reestablishing corner:

G-5

1996 Remonumentation  
by James A. Beck  
P.S. 21559  
found 1/2" rod with R.L.S. 14102 cap  
Witnesses:  
S 60°E 3" B.Ash 9.85'  
S 55°W 9" Cedar 9.75'  
N 20°E, 8" Cedar 15.21'


Ratified by Peer Group  
in accordance with P.A. 345  
Chairman *James A. Beck*  
Date 5/22/96

C. Description of monument for corner and accessories established to perpetuate locating the position of the corner:

G-5

1996 Remonumentation  
by James A. Beck  
P.S. 21559  
1/2" rod with 14102 cap  
Witnesses:  
S 60°E 3" B.Ash 9.85'  
S 55°W 9" Cedar 9.75'  
N 20°E, 8" Cedar 15.21'  
N 33°W 8" B. Ash 33.87'

set 21559 tags  
under nails from  
previous recordation

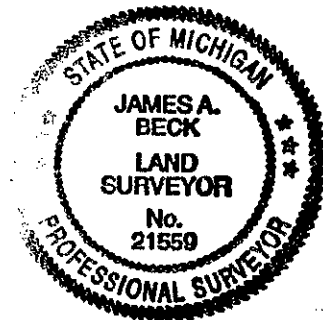

Signed by *James A. Beck*  
Surveyor's Michigan License No. 21559

Date June 17, 1996