

1997 PRESQUE ISLE COUNTY STATE OF MICHIGAN REMONUMENTATION

LAND CORNER RECORDATION CERTIFICATE
Filing Requirement of Act 74, Mich. P.A. 1970

LIBER 325 PAGE 078

For corners in

Presque Isle
(County)

Located In:
Belknap Twp.

Corner Code #

1. Public Land Survey

T 34N 5E H3
T R
T R
T R
T R
S T R
S T R
S T R
S T R

2. Property Controlling
in Section

3. Miscellaneous
Property in Sec.

PRESQUE ISLE COUNTY
RECORDED

97 DEC 18 AM 9:55

Jana M. Schmitt
REGISTER OF DEEDS

Register of Deeds Stamp & File Number

4. Lot No. _____, Recorded Plat _____

5. Private Claims _____

JAMES A. BECK

OCT 30 97

I, _____, in a field survey on _____, 19____ do hereby state that under requirements of P.A. 74, Michigan P.A. of 1970, the corner points mentioned in lines 1 and 2 above were in conformance with regulations and rules therefore as required in the current manual of survey instructions of the United States Department of the Interior, Bureau of Land Management or by a decree of a Court of Law and /or that the corner points mentioned in lines 3, 4 and 5 above were in conformance with the rules of the Michigan Board of Land Surveyors or by a Decree of a Court of Law; established, re-established, monumented, recovered, found as expressed below:

NOTE: Not more than 2 corners, all in the same town and range, may be recorded on this certificate.

	A	B	C	D	E	F	G	H	I	J	K	L	M
1													
2	6		5		4		3		2		1		
3								10		11		12	
4	7		8		9		10		11		12		
5													
6	18		17		16		15		14		13		
7													
8	19		20		21		22		23		24		
9													
10	30		29		28		27		26		25		
11													
12	31		32		33		34		35		36		
13													

A. Description of original monument and accessories and/or subsequent restoration:

H3 Date: 1856 GLO Alfred Millerd
"Set qr. Sec. post"
Cedar 12 N8E 11
Cedar 8 S20W 39
SEE REVERSE SIDE OF CERTIFICATE FOR ADDITIONAL ACTIVITY AT CORNER

SURVEY &
REMONUMENTATION

JAN 14 1998

B. Description of corner evidence found and/or method applied in restoring or reestablishing corner:

H3
1997 Remonumentation by James A. Beck, P.S. 21559
Set 1/2" iron rod and P.S. 21559 cap using Mar. 29, 1982 recorded accessories
" S63°W 55.66', 4" White Birch"
"N 43°W 57.97', 4" Balsam"

SECTION


C. Description of monument for corner and accessories established to perpetuate locating the position of the corner:

H3 1/2" iron rod with P.S. 21559 cap

Witnesses:

S 63°W 55.66 ft., stump of 4" White Birch
N 43°W 57.97 ft., P.S. 21559 tag in 7" Balsam
N 70°E 49.81 ft., P.S. 21559 tag in 6" Cedar
S 20°E 31.26 ft., P.S. 21559 tag in 3" Ash
S 32°W 31.87 ft., P.S. 21559 tag in 2" Ash

Ratified by Peer Group
in accordance with P.A. 345
Chairman *Norman J. Quam*
Date 11/13/97

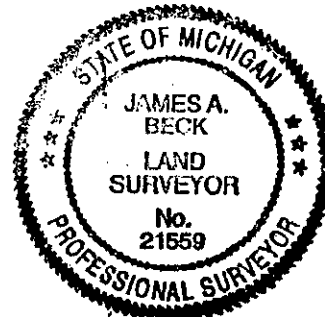

Signed by

Surveyor's Michigan License No. 21559

Date

12/8/1997

PART "A" OF CERTIFICATE CONTINUED

LIBER 325 PAGE 079

1958 Field Notes as furnished by David Guthrie Reg. No. 22435 of Scott Engineering
"Shot cl of Rd. no cor found" (notes depict fence running Nly of point shot)

Date: Mar. 29, 1982

P.A. 74 (Land Corner Recordation) Certificate by Ronald Bischer Reg. No. 22428
Monument found & Recorded: " Found RxR Spike"

Accessories:

N 43°W 57.97' 4" Balsam

S 63°W 55.66' 4" W. Birch

S 15°W 29.10', 4"W. Birch