

LIBER 325 PAGE 194

LAND CORNER RECORDATION CERTIFICATE  
Filing Requirement of Act 74, Mich. P.A. 1970

97 DEC 23 AM 11:18

For corners in

Presque Isle  
(County)

Located In:

Corner Code #

1. Public Land Survey

T4N R5E L-5

T R

T R

T R

2. Property Controlling  
in Section

S T R

S T R

3. Miscellaneous  
Property in Sec.

S T R

S T R

4. Lot No. \_\_\_\_\_, Recorded Plat \_\_\_\_\_

5. Private Claims \_\_\_\_\_

I, Delmer E. Porter in a field survey on 3-5, 1997 do hereby state that under requirements of P.A. 74, Michigan P.A. of 1970, the corner points mentioned in lines 1 and 2 above were in conformance with regulations and rules therefore as required in the current manual of survey instructions of the United States Department of the Interior, Bureau of Land Management or by a decree of a Court of Law and/or that the corner points mentioned in lines 3, 4 and 5 above were in conformance with the rules of the Michigan Board of Land Surveyors or by a Decree of a Court of Law; established, re-established, monumented, recovered, found as expressed below:

NOTE: Not more than 2 corners, all in the same town and range, may be recorded on this certificate.

	A	B	C	D	E	F	G	H	I	J	K	L	M
1													
2	6		5		4		3		2		1		
3													
4	7		8		9		10		11		12		
5													
6	18		17		16		15		14		13		
7													
8	19		20		21		22		23		24		
9													
10	30		29		28		27		26		25		
11													
12	31		32		33		34		35		36		
13													

A. Description of original monument and accessories and/or subsequent restoration:

L-5			
GLO Notes	Set Qr. Sec Post	D. Porter, #15410	Set 1" Pipe @ FE Cor Pc
Alfred Millard	B. Ash 11" N65° E 6 Lk	Act 74 Filing	N50° W 82.48' 5" Cedar
July 8, 1856	Sugar 12" S42° W 34 Lk	Aug. 8, 1974	North 14.68' FE Post
		L. 1 Pg. 61	N30° E 54.34' 24" Cedar
			Stump

"Continued on Back"


B. Description of corner evidence found and/or method applied in restoring or reestablishing corner:

L-5  
Fd. 1" Pipe @ FE Cor. N-S-E-W  
N47° W 82.32' 9" Cedar  
N08° E 15.29' FE Post

Ratified by Peer Group  
in accordance with P.A. 345  
Chairman Norman J. Quinn  
Date 12/04/97

C. Description of monument for corner and accessories established to perpetuate locating the position of the corner:

L-5  
1" Pipe @ FE Cor. N-S-E-W  
N47° W 82.32' 9" Cedar  
N08° E 15.29' FE Post  
S83° W 23.24' 6" Birch  
N81° W 19.51' 3" Cedar

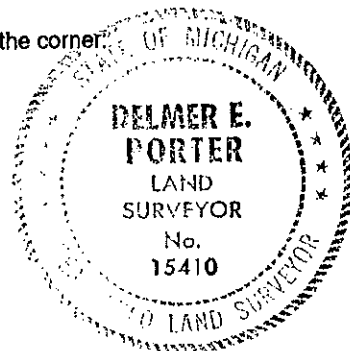

Signed by Delmer E. Porter  
Surveyor's Michigan License No. 15410

Date 12/18/97

A Continued:

L-5

D. Porter, #15410

Act 132 Survey

Aug. 8, 1974

L. 206 Pg. 228

1" Pipe

N50°W 82.48' 5" Cedar

N30°E 54.34' 24" Stump