

LAND CORNER RECORDATION CERTIFICATE
Filing Requirement of Act 74, Mich. PA 1970


For Corners In: Presque Isle (County) Located In Corner Code #
1. Public Land Survey T R
2. Property Controlling in Section S 16 T 35N R 2E 7
3. Miscellaneous Property in Section S T R

4. Lot No: Recorded Plat:
5. Private Claims:

I, Carl T. Kiiskila, in a field survey on December 14, 2011 do hereby state that under requirements of PA 74, Michigan PA of 1970, the corner points mentioned in lines 1 and 2 above were in conformance with regulations and rules therefore as required in the current manual of survey instructions of the United States Department of the Interior, Bureau of Land Management or by a decree of a Court of Law and/or that the corner points mentioned in lines 3, 4 and 5 above were in conformance with the rules of the Michigan Board of Land Surveyors or by a Decree of a Court of Law; established, re-established, monumented, recovered, found as expressed below:

NOTE: Not more than 2 corners, all in the same town and range, may be recorded on this certificate.

Register of Deeds Stamp & File Number

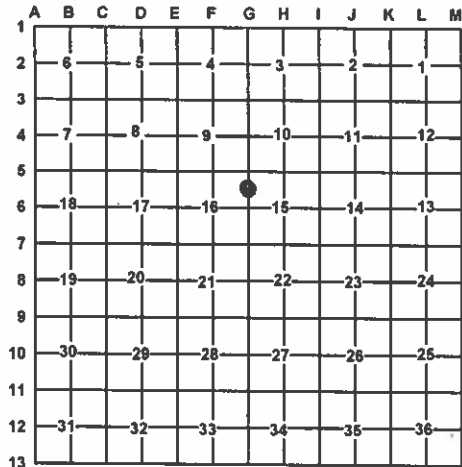

A. Description of original monument and accessories and/or subsequent restoration:

7 - North 1/16 Corner comm. to sec.'s 15 & 16, T35N, R02E
This corner was not set during the original survey.

B. Description of corner evidence found and/or method applies in restoring or re-establishing corner:

7 - North 1/16 Corner comm. to sec.'s 15 & 16, T35N, R02E
Set a stamped 2" dia. aluminum cap on 5/8"x32" rerod per standard BLM procedure for subdivision of a section.

C. Description of monument for corner and accessories established to perpetuate locating the position of the corner:

7 - North 1/16 Corner comm. to sec.'s 15 & 16, T35N, R02E
stamped 2" dia. aluminum cap on 5/8"x32" rerod
Wit: N57°E 29.48' to set N&T on SW side 6" Balsam Fir
S04°W 26.40' to set N&T on W side 8" Balsam Fir
S72°W 29.78' to set N&T on S side 16" W. Pine
N27°W 10.00' to set N&T on W side 4" Balsam Fir
Fence Corner West 40'
Set Blue Carsonite Post w/ location tag 1' North



Carl T Kiiskila

Surveyor's Michigan License No.: 33981

4-18-12