

LAND CORNER RECORDATION CERTIFICATE

Filing Requirement of Act 74, Mich. PA 1970

For Corners In:
Presque Isle
(County)

Located In

Corner Code #

1. Public Land Survey T R
T R
2. Property Controlling in Section S 16 T 35N R 2E 1
S 16 T 35N R 2E 3
3. Miscellaneous Property in Section S T R
S T R


4. Lot No: Recorded Plat:

5. Private Claims:

I, Carl T. Kiiskila, in a field survey on December 3, 2011 do hereby state that under requirements of PA 74, Michigan PA of 1970, the corner points mentioned in lines 1 and 2 above were in conformance with regulations and rules therefore as required in the current manual of survey instructions of the United States Department of the Interior, Bureau of Land Management or by a decree of a Court of Law and/or that the corner points mentioned in lines 3, 4 and 5 above were in conformance with the rules of the Michigan Board of Land Surveyors or by a Decree of a Court of Law; established, re-established, monumented, recovered, found as expressed below:

NOTE: Not more than 2 corners, all in the same town and range, may be recorded on this certificate.

Register of Deeds Stamp & File Number

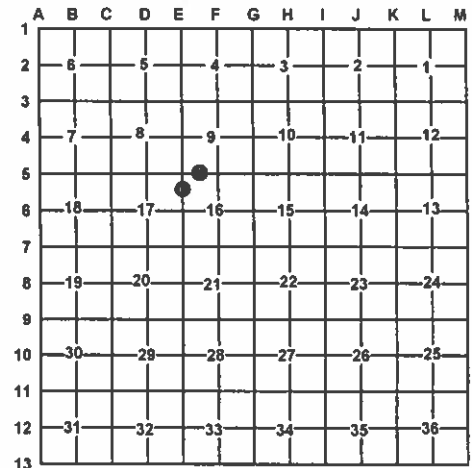

A. Description of original monument and accessories and/or subsequent restoration:

1 - West 1/16 Corner comm. to sec.'s 9 & 16, T35N, R02E

3 - North 1/16 Corner comm. to sec.'s 16 & 17, T35N, R02E

This corner was not set during the original survey.

This corner was not set during the original survey.

B. Description of corner evidence found and/or method applies in restoring or re-establishing corner:

1 - West 1/16 Corner comm. to sec.'s 9 & 16, T35N, R02E

3 - North 1/16 Corner comm. to sec.'s 16 & 17, T35N, R02E

Found and accepted a concrete monument fitting the standard procedure for subdivision of a section added PS Cap#33981.
Found no other evidence to dispute the location for the corner.

Set a stamped 2" dia. aluminum cap on 5/8"x32" rerod per standard BLM procedure for subdivision of a section.

C. Description of monument for corner and accessories established to perpetuate locating the position of the corner:

1 - West 1/16 Corner comm. to sec.'s 9 & 16, T35N, R02E

3 - North 1/16 Corner comm. to sec.'s 16 & 17, T35N, R02E

Conc. Mon. with PS cap#33981

Stamped 2" dia. aluminum cap on 5/8"x32" rerod

Wit: S10°W 25.21' to set N&T on E side 10" R. Pine
S85°W 3.63' to set N&T on S side 4" Spruce
N52°W 25.51' to set N&T on N side 13" R. Pine
N04°W 15.95' to set N&T on W side 12" W. Pine

Wit: N38°E 155.03' to set N&T on NW side 7" J. Pine
S85°E 45.56' to set 2" dia. aluminum cap on rerod
GPS base station iron and cap
S59°W 22.77' to set N&T on N side 4" J. Pine
N14°W 110.60' to set N&T on W side 4" W. Pine
Ctr N-S gravel road East 10'

Set Blue Carsonite Post w/ location tag 1' North

Set Blue Carsonite Post w/ location tag 36' East

Surveyor's Michigan License No.: 33981

Carl T. Kiiskila

4-18-12

