


LAND CORNER RECORDATION CERTIFICATE
Filing Requirement of Act 74, Mich. PA 1970

For Corners In: Presque Isle (County)
Located In
Corner Code #
1. Public Land Survey
2. Property Controlling in Section
3. Miscellaneous Property in Section
4. Lot No:
5. Private Claims:

I, Carl T. Kiiskila, in a field survey on August 11, 2009 do hereby state that under requirements of PA 74, Michigan PA of 1970, the corner points mentioned in lines 1 and 2 above were in conformance with regulations and rules therefore as required in the current manual of survey instructions of the United States Department of the Interior, Bureau of Land Management or by a decree of a Court of Law and/or that the corner points mentioned in lines 3, 4 and 5 above were in conformance with the rules of the Michigan Board of Land Surveyors or by a Decree of a Court of Law; established, re-established, monumented, recovered, found as expressed below:

NOTE: Not more than 2 corners, all in the same town and range, may be recorded on this certificate.

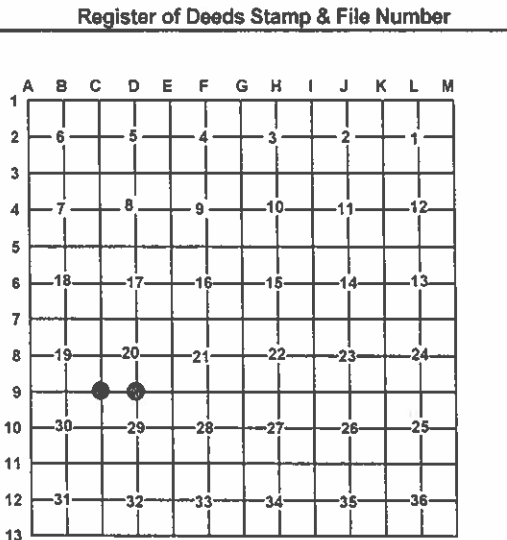

A. Description of original monument and accessories and/or subsequent restoration:

C-9 Section Corner comm. to sec.'s 19,20,29 & 30, T36N,R2E
1856 - GLO - George H. Cannon - Set section post.
Y.Pine 14" S60°W 6 links
Y.Pine 12" N35°E 96 links
1978 - L.C.R.C.#342 - Delmer E. Porter, P.S.#15410 - Fd. "T" at inter. of two sand trails. Assumed to be DeLaMater/Muschell Cor..
Reset position with 4"conc. Mon. with brass cap.
N18°W 51.97' 7" Maple Clump; S55°W 30.83' 7" W.Pine; S48°E 16.48' 7" Maple Clump
1994 - L.C.R.C - L.311, p.122 - Norman J. Quaine, P.S.#33984 - Found conc. Mon. per Porter.
N18°W 51.79' 9" Maple; N41°E 27.13' 7" Aspen; S49°E 16.73' 10" Maple; S73°W 60.55' 5" W.Pine; N74°W 27.88' 16" Oak
1997 - Carl T. Kiiskila, P.S.#33981 - Fd. and accepted mon. in inter. of trail roads. 8" Aspen N44°E 26.92'; 10" Maple S45°E 16.69'; 12" Oak S05°W 40.70'; 18" Oak N74°W 27.64'
D-9 1/4 Corner comm. to sec.'s 20 & 29, T36N,R2E
1856 - GLO - George H. Cannon - Gov. Dependent Resurvey
Y.Pine 14" N66°E 27 links
Y.Pine 15" S76°W 71 links
1978 - L.C.R.C.#342/343 - Delmer E. Porter, P.S.#15410 - Fd. 1/4" Pipe at inter. of two sand trails. No wits. Reset position with 4"conc. Mon. with brass cap. N30°W 43.80' 8" N.Pine; S14°W 40.10' 6" W.Pine; S57°E 30.93' 5" W.Pine
1994 - Remon L.C.R.C - L.311, p.126 - Norman J. Quaine, P.S.#33984 - Found conc. mon. & P.I. Co. Remon brass cap. N30°W 43.70' 14" N.Pine; N65°E 18.57' 5" W.Pine; S16°W 39.83' 12" W.Pine; S51°E 30.88' 9" W.Pine
1997 - Carl T. Kiiskila, P.S.#33981 - Fd. and accepted P.I. Co. mon for N1/4 Cor. Sec. 29. 14" R.Pine N26°W 43.66' 6" W.Pine N68°E 18.52'; 8" W.Pine S54°E 30.87' 12" W.Pine S15°W 39.74' Set Carsonite Post South 10'

B. Description of corner evidence found and/or method applies in restoring or re-establishing corner:

C-9 Section Corner comm. to sec.'s 19,20,29 & 30, T36N,R2E
Found 4" conc. Mon. with 3" brass cap down 0.4' below grade in trail roads intersection per L.C.R.C #342. Accepted found conc. Mon. as the best available evidence for the position of the original corner. Found no other evidence to dispute the location for the corner.
D-9 1/4 Corner comm. to sec.'s 20 & 29, T36N,R2E
Found 4" conc. Mon. with 3" brass cap down just below grade per L.C.R.C.#342/343. Accepted found conc. Mon. as the best available evidence for the position of the original corner. Found no other evidence to dispute the location for the corner.

C. Description of monument for corner and accessories established to perpetuate locating the position of the corner:

C-9 Section Corner comm. to sec.'s 19,20,29 & 30, T36N,R2E
Fd. 4" dia. Conc. Mon. with 3" dia. stamped brass cap.
Wit: \*N33°E 27.13' to fd. nail on SE side 11" Poplar
N67°E 57.84' to set N&T on NW side 6" W.Pine
\*S41°E 16.67' to fd. nail on SW side 10" Twin R.Maple
\*S02°E 40.66' to fd. nail on E side 17" R.Oak
\*N67°W 27.64' to fd. nail on NE side 20" Twin R. Oak
Fd. Blue Carsonite Post w/ loc. Tag S45°W 33'
D-9 1/4 Corner comm. to sec.'s 20 & 29, T36N,R2E
Fd. 4" dia. Conc. Mon. with 3" dia. stamped brass cap.
Wit: \*N63°E 18.56' to fd. N&T on S side 11" W.Pine
S50°E 47.22' to set N&T on SW side 8" W.Pine (scribed 'XBT')
\*S15°W 39.70' to fd. N&T on NW side 13" W.Pine
\*S44°W 77.57' to set N&T on NW side 17" R.Oak
\*N30°W 43.63' to fd. N&T on NE side 18" R.Pine
Fd. Blue Carsonite Post w/ loc. Tag south 33'

\* Previous recorded witness.

Carl T. Kiiskila

Surveyor's Michigan License No.: 33981

\* Previous recorded witness.

10-8-09

