

SURVEY &
RECORDATION
1995 PRESQUE ISLE COUNTY, STATE OF MICHIGAN REMONUMENTATION

2039
JAN 17 1996

LAND CORNER RECORDATION CERTIFICATE
COMMISSION Filing Requirement of Act 74, Mich. P.A. 1970

For corners in
PRESQUE ISLE
(County)

Located In:

Corner Code #

LIBER 316 PAGE 322
PRESQUE ISLE COUNTY
RECORDED

95 OCT 20 PM 4:36

Janet M. Schombert
REGISTER OF DEEDS

Register of Deeds Stamp & File Number

1. Public Land Survey T 36N R 2E M-4
T _____ R _____
T _____ R _____
T _____ R _____
2. Property Controlling S _____ T _____ R _____
in Section S _____ T _____ R _____
3. Miscellaneous S _____ T _____ R _____
Property in Section S _____ T _____ R _____
4. Lot No. _____, Recorded Plat _____
5. Private Claims _____

I, Ronald Bischer, in a field survey on August 8, 19 95, do hereby certify that under requirements of P.A. 74, Michigan P.A. of 1970, the corner points mentioned in lines 1 and 2 above were in conformance with regulations and rules therefore as required in the current manual of survey instructions of the United States Department of the Interior, Bureau of Land Management or by a decree of a Court of Law and/or that the corner points mentioned in lines 3, 4 and 5 above were in conformance with the rules of the Michigan Board of Professional Surveyors or by a Decree of a Court of Law; established, re-established, monumented, re-monumented, recovered, found as expressed below:


NOTE: Not more than 4 corners, all in the same town and range, may be recorded on this certificate.

A. Description of original monument and accessories and/or subsequent restoration:

GLO Notes - 1856 Resurvey South 39.62' 6" Oak
Geo. H. Cannon N10°E 4.64' 5" Maple
Set wood post N65°W 19.29' Tw. Maple
W. Birch 7" N84½°W 14 lks 02-06-75, 05-03-84
W. Pine 13" S49°W 26 lks Delmar E. Porter
02-04-75 - Delmar E. Porter same corner and witness as on 02-04-75
#15410, Found 1" Pipe
N71°W 21.00' 20" Pine stump

B. Description of corner evidence found and/or method applied in restoring or reestablishing corner:

Found 1" Pipe, set ½" Rod and Cap #22428 inside of pipe.
N63°W 19.29' 8" Maple
N08°E 4.87' 9" Maple
S03°E 39.62' 12" Oak
S49°W remains of pine stump - possible O.B.T. stump

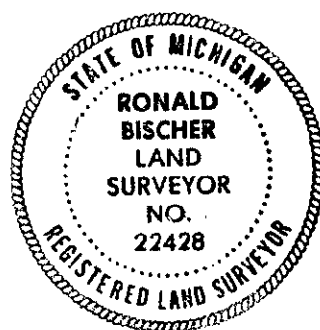

C. Description of monument for corner and accessories established to perpetuate locating the position of the corner:

½" Rod and Cap #22428 in 1" pipe
N63°W 19.29' 8" Maple
N08°E 4.87' 9" Maple
S03°E 39.62' 12" Oak
S58°W 23.64' 4" White Pine

Nails with witness tag #22428 used.

Ratified by Peer Group
in accordance with P.A. 345
Chairman *Delmar E. Porter*
Date 9/20/95

Signed by Ronald R. Bischer

Date Oct. 3, 1995

Surveyor's Michigan License No. 22428