

8938

ROSCOMMON COUNTY REMONUMENTATION

STATE OF MICHIGAN
COUNTY OF ROSCOMMON
RECORDED

COMMISSION

LAND CORNER RECORDATION CERTIFICATE

Filing Requirement of Act 74, Mich. P.A. 1970

Dec 16 9 19 AM '93

Robert W. Smith
REGISTER OF DEEDS

For corners in

Roscommon
(County)

Located in:

Corner Code #

1. Public Land Survey

T 21N R 1W

B-7

T R

T R

T R

2. Property Controlling
in Section

S T R

S T R

3. Miscellaneous

S T R

Property in Sec

S T R

4. Lot No. , Recorded Plat

5. Private Claims

ROSCOMMON COUNTY
PEER GROUP APPROVAL
DATE 11-30-93

TO BE FILED IN LIBER 3 OF LAND CORNERS

Register of Deeds Stamp & File Number

I, Larry L. Cavanagh in a field survey on November 19 93

do hereby certify that under requirements of P.A. 74, Michigan P.A. of 1970, the corner points mentioned in lines 1 and 2 above were in conformance with regulations and rules therefore as required in the current manual of survey instructions of the United States Department of the Interior, Bureau of Land Management or by a decree of a Court of Law and/or that the corner points mentioned in lines 3, 4 and 5 above were in conformance with the rules of the Michigan Board of Land Surveyors or by a Decree of a Court of Law, established, re-established, monumented, re-monumented, recovered, found as expressed below.

NOTE: Not more than 4 corners, all in the same town and range, may be recorded on this certificate.

A. Description of original monument and accessories and/or subsequent restoration:

W/post placed by Wm A. Burt 1850

Hemlock 18" N70°W 12

Birch 6" S85°E 18

1947 George D. Henning land survey

1"x24" pipe in corner

BT 14" Maple N12°W 37.8

BT 10" Beech N57°W 22.5

Steel fence post in corner

1975± Liber 2 corner record

1"x24" pipe in corner

BT 12" Maple N12°W 37.8

BT 10" Beech N57°W 22.5

Steel fence post in corner

B. Description of corner evidence found and/or method applied in restoring or reestablishing corner:

Found 1" pipe under corner fence post

Maple witness NW varifies corner

Accepted as the best available evidence of the position of the original corner.

See filed dossier for detail of report.

C. Description of monument for corner and accessories established to perpetuate locating the position of the corner:

Set Roscommon Co. Std. Mon stamped B-7 17614


S33°W Nail & tag in 7" Scotch Pine 29.15

N75°E Nail & tag in 5" Cherry 24.5

N12°W Nail & tag in 28" Maple 38.0

N30°E Nail & tag in 7" Basswood 58.05

Carsonite post West 1.78

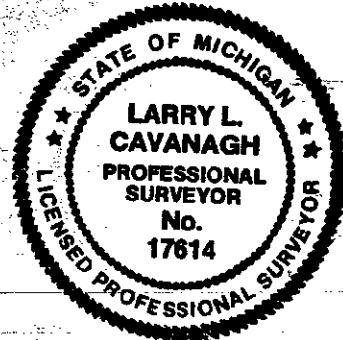

Signed by

Larry L. Cavanagh

Date

12-15-93

Surveyor's Michigan License No.

17614

Date

November 30, 1993

Peer Group Approved

FORM APPROVED BY MICHIGAN STATE BOARD OF LAND SURVEYORS, JAN. 28, 1971
REVISED MAY 14, 1975
REVISED JAN., 1983

LIBER

3

PAGE

4