

SURVEY & REMONUMENTATION

APR 07 1998

SECTION

9245

LAND CORNER RECORDATION CERTIFICATE Filing Requirement of Act 74, Mich P.A. 1970

STATE OF MICHIGAN
ROSCOMMON COUNTY
RECORDED

For corners in
Roscommon County

Located in: Corner Code #

1. Public Land Survey

T21N R1W D-9
T R
T R
T R

16 DEC 97 12:26 P.M.

ROBERT W. SMITH
REGISTER OF DEEDS

FILE IN LIBER 3 OF LAND CORNER

Register of Deeds Stamp & File Number

I, Larry L. Cavanagh, in a field survey April, 1997, do hereby certify that under requirements of P.A. 74, Michigan P.A. of 1970, the corner points mentioned in line 1 above was in conformance with regulations and rules therefore as required in the current manual of survey instructions of the United States Department of the Interior, Bureau of Land Management or by a decree of a Court of Law; established, re-established, monumented, recovered, found as expressed below:

A. Description of original monument and accessories and/or subsequent restoration:

WILLIAM A BURT 1850
SET POST
BEECH 12" S45°E 44 LKS
BEECH 8" N25°W 39 LKS

HENNING SECTION SURVEY 1941
SET 3/4" X 24" PIPE AT SINGLE
PROPORTIONATE DIST.
OAK 5" N68°W 70.0'
POPLAR 8" N68°E 45.5'

HENNING 1979 UNRECORDED SURVEY
FD 3/4" PIPE
12" POPLAR N25°E 35.3'
6" MAPLE S58°E 43.3'
6" MAPLE S64°W 64.2'

LARRY CAVANAGH UNRECORDED SURVEY
FD 3/4" PIPE
12" MAPLE N57°W 77.10'
12" MAPLE N25°W 51.55'
6" MAPLE S58°E 43.43'
6" MAPLE S64°W 64.21'

	A	B	C	D	E	F	G	H	I	J	K	L	N
2	6	5	4	3	2	1							
3													
4	7	8	9	10	11	12							
5													
6	18	17	16	15	14	13							
7													
8	19	20	21	22	23	24							
9													
10	30	29	28	27	26	25							
11													
12	31	32	33	34	35	36							
13													

B. Description of corner evidence found and/or method applied in restoring or reestablishing corner:

FOUND 3/4" X 24" PIPE
BOTH 1979 HENNING MAPLE WITNESSES

C. Description of monument for corner and accessories established to perpetuate locating the position of the corner:

SET ROSCOMMON COUNTY MONUMENT STAMPED 17614
NAIL & TAG IN 12" MAPLE N57°W 77.10'
NAIL & TAG IN 12" MAPLE N25°W 51.55'
NAIL & TAG IN 6" MAPLE S58°E 43.43'
NAIL & TAG IN 6" MAPLE S64°W 64.21'
CARSONITE POST SOUTH 0.5'


THE BEST AVAILABLE EVIDENCE OF THE POSITION OF THE ORIGINAL CORNER.

ROSCOMMON COUNTY
PEER GROUP APPROVAL
DATE Dec 5, 1997

Marvin E. Myers
Marvin E. Myers, P.S.
County Surveyor

Signed by *Larry L. Cavanagh*
Surveyor's Michigan License NO. 17614

Date Dec. 11, 1997

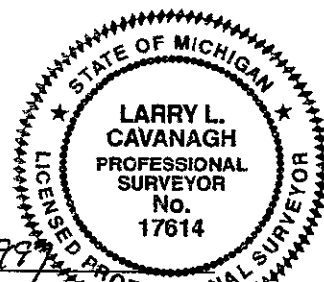

FORM APPROVED BY MICHIGAN STATE BOARD OF LAND SURVEYORS, JAN 28, 1971
REVISED MAY 14, 1975
REVISED JAN., 1983

LIBER 3 Page 470