

SURVEY & REMONUMENTATION

APR 07 1998

SECTION

9208

LAND CORNER RECORDATION CERTIFICATE Filing Requirement of Act 74, Mich. P.A. 1970

For Corners in Roscommon (County)	Located In:	Corner Code #
1. Public Land Survey	T 21N R 1W	E-4
	T R	
	T R	
	T R	
2. Property Controlling in Section	S T R	
	S T R	
3. Miscellaneous Property in Sec.	S T R	
	S T R	

STATE OF MICHIGAN
ROSCOMMON COUNTY
RECORDED

16 DEC 97 10:16 A.M.

ROBERT W. SMITH
REGISTER OF DEEDS

FILE IN LIBER 3 OF LAND CORNERS
Register of Deeds Stamp & File Number

4. Lot No. _____, Recorded Plat _____
5. Private Claims _____

I, Gerald J. Gray, in a field survey on May 11, 1994, do hereby certify that under requirements of P.A. 74, Michigan P.A. of 1970, the corner points mentioned in lines 1 and 2 above were in conformance with regulations and rules therefore as required in the current manual of survey instructions of the United States Department of the Interior, Bureau of Land Management or by a decree of a Court of Law and/or that the corner points mentioned in lines 3, 4, and 5 above were in conformance with the rules of the Michigan Board of Land Surveyors or by a Decree of a Court of Law; established, re-established, monumented, re-monumented, recovered, found as expressed below:

Note: Not more than 4 corners, all in the same town and range, may be recorded on this certificate.

A. Description of original monument and accessories and/or subsequent restoration:

- 1) Wm. A. Burt 1850
Y. Pine 30 N82E 30
B. Oak 4 S40W 25

	A	B	C	D	E	F	G	H	I	J	K	L	M
1													
2	6		5		4		3		2		1		
3													
4	7		8		9		10		11		12		
5													
6	18		17		16		15		14		13		
7													
8	19		20		21		22		23		24		
9													
10	30		29		28		27		26		25		
11													
12	31		32		33		34		35		36		
13													

ROSCOMMON COUNTY
PEER GROUP APPROVAL
DATE MAY 17, 1994

Marvin E. Myers
Marvin E. Myers, P.S.
County Surveyor

B. Description of corner evidence found and/or method applied in restoring or reestablishing corner:

No evidence found. Established corner mid-way on line.

Set 1/2" iron rod & cap

C. Description of monument for corner and accessories established to perpetuate locating the position of the corner:

Set Standard Roscommon County Monument

Set Nail	4" Maple	N50°W 7.35'
Set Nail	6" Maple	S54°W 18.72'
Set Nail	4" W. Oak	S39°W 25.75'
Set Nail	Twin 4" Maple	N52°E 25.75'


Signed by

Gerald J. Gray

Date

Surveyor's Michigan License No.

17741

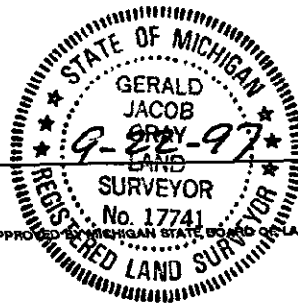

FORM APPROVED BY MICHIGAN STATE BOARD OF LAND SURVEYORS, JAN. 28, 1971
REVISED MAY 14, 1975
REVISED JAN., 1983

LIBER 3 PAGE 442