

SURVEY &  
REMONUMENTATION

ROSCOMMON COUNTY REMONUMENTATION

7137

APR 24 1995

LAND CORNER RECORDATION CERTIFICATE

Filing Requirement of Act 74, Mich. P.A. 1970

STATE OF MICHIGAN  
COUNTY OF

SEP 23 3 03 PM '94

For corners in  
ROSCOMMON

(County)

COMMISSION

Located In:

Corner Code =#

1. Public Land Survey T 21N R 2W M-13  
T R  
T R  
T R  
2. Property Controlling S T R  
in Section S T R  
3. Miscellaneous S T R  
Property in Sec. S T R

4. Lot No. , Recorded Plat  
5. Private Claims

TO BE FILED IN LIBER 3 OF LAND CORNERS  
Register of Deeds Stamp & File Number

Timothy L. Lapham June 94  
I, in a field survey on , 19

do hereby certify that under requirements of P.A. 74, Michigan P.A. of 1970, the corner points mentioned in lines 1 and 2 above were in conformance with regulations and rules therefore as required in the current manual of survey instructions of the United States Department of the Interior, Bureau of Land Management or by a decree of a Court of Law and/or that the corner points mentioned in lines 3, 4 and 5 above were in conformance with the rules of the Michigan Board of Land Surveyors or by a Decree of a Court of Law; established, re-established, monumented, re-monumented, recovered, found as expressed below:

**NOTE: Not more than 4 corners, all in the same town and range, may be recorded on this certificate.**

	A	B	C	D	E	F	G	H	I	J	K	L	M
2	6	5	4	3	2	1							
3													
4	7	8	9	10	11	12							
5													
6	18	17	16	15	14	13							
7													
8	19	20	21	22	23	24							
9													
10	30	29	28	27	26	25							
11													
12	31	32	33	34	35	36							
13													

A. Description of original monument and accessories and/or subsequent restoration:

M-13: 1837, BRINK, POST, YELLOW PINE 16" S38E 77LKS, YELLOW PINE 20" N83E 83LKS;  
DATE UNKNOWN, SURVEYOR UNKNOWN, OLD COR. REC. 2-30, COR MAT, NO WITS;  
3/7/1986, MEYERS, SURVEY 477-681, COR MATERIAL, 3 WITNESSES;  
1990, CAVANAGH, SURVEY 572-549 TO 554, COR MAT, 4 WITS;  
6/5/1990, CAVANAGH, LCRC 1-281, COR MAT, 4 WITS;

B. Description of corner evidence found and/or method applied in restoring or reestablishing corner:

M-13: FOUND 3/4" X 36" PIPE, EXCAVATED TO 3 FEET AND FOUND NO FURTHER EVIDENCE;  
FOUND ACCESSORIES  
S27E 54.77' P.POLE  
N33W 121.2' 28" ASH  
S80W 88.1' 15" CHERRY  
N25E 93.9' 2" ELDER  
ACCEPTED FOUND CORNER AS BEST AVAILABLE EVIDENCE OF THE LOCATION OF THE ORIGINAL CORNER.  
THIS CORNER ESTABLISHED IN ACCORDENCE WITH THE ROSCOMMON REMONUMENTATION PROGRAM. SEE  
DOSSIER FOR DETAILED REPORT.

C. Description of monument for corner and accessories established to perpetuate locating the position of the corner:

M-13: SET A 2 1/2" x 24" CAST IRON MONUMENT 6" BELOW GRAVEL SURFACE WITH BRASS DISK MARKED  
"ROSCOMMON COUNTY, 1994 27595"  
S27E 54.77' SPIKE & TAG IN P.POLE  
N33W 122.16' SPIKE & TAG IN 28" ASH  
S80W 88.1' SPIKE & TAG IN 15" CHERRY  
N25E 93.85' SPIKE & TAG IN 2" ELDER  
CORNER FALLS IN EAST-WEST ROAD ON EXTENSION OF ROAD NORTH


ROSCOMMON COUNTY  
PEER GROUP APPROVAL  
DATE 7-29-94

Signed by

Date

Surveyor's Michigan License No. 27595

FORM APPROVED BY MICHIGAN STATE BOARD OF LAND SURVEYORS, JAN. 28, 1971  
REVISED MAY 14, 1975  
REVISED JAN., 1983

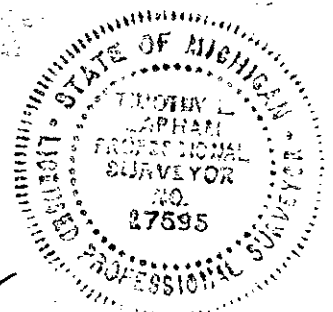

LIBER 3 PAGE 97