

# SURVEY & REMONUMENTATION

MAY 28 1997

COMMISSION

4727

## LAND CORNER RECORDATION CERTIFICATE Filing Requirement of Act 74, Mich. P.A. 1970

STATE OF MICHIGAN  
ROSCOMMON COUNTY  
RECORDED

11 JUL 96 11:28 A.M.

ROBERT W. SMITH  
REGISTER OF DEEDS

For corners in  
Roscommon  
(County)

Located In:

Corner Code #

1. Public Land Survey

T 22N R 2W

K - 7

T R

T R

T R

2. Property Controlling  
in Section

S T R

S T R

3. Miscellaneous

S T R

Property in Section

S T R

4. Lot No. , Recorded Plat

5. Private Claims

TO BE FILED IN LIBER 3 OF LAND CORNER  
Register of Deeds Stamp & File Number

I, Marvin E. Myers, in a field survey on June 18, 1996,  
do hereby certify that under requirements of P.A. 74, Michigan P.A. of 1970, the corner points mentioned  
in lines 1 and 2 above were in conformance with regulations and rules therefore as required in the current  
manual of survey instructions of the United States Department of the Interior, Bureau of Land  
Management or by a decree of a Court of Law and/or that the corner points mentioned in lines 3, 4 and  
5 above were in conformance with the rules of the Michigan Board of Professional Surveyors or by a  
Decree of a Court of Law; established, re-established, monumented, re-monumented, recovered, found  
as expressed below:

**NOTE:** Not more than 4 corners, all in the same town and range, may be recorded  
on this certificate.

### A. Description of original monument and accessories and/or subsequent restoration:

GLO - 1852 W. Burt

Mon - Post

Wit - 14" Hemlock N57°E 5 Lks  
16" W. Pine S44°W 23 Lks

L. 2, P. 193

Mon - 1" Sq. Iron Bar

Wit - 4" Cedar S13°E 31.53

5" Cedar S14°W 59.75

18" Pine Stump N18°E 41.44

24" Pine Stump N33°W 42.63

Sept 1974 LL Cavanagh

Mon - Found 1" Iron

Wit - (Same as L.2, P. 193)

### B. Description of corner evidence found and/or method applied in restoring or reestablishing corner:

Found 1" x 27" Iron 5'± South of centerline E-W road. Found both pine stump recorded in Liber 2, page 193  
Accepted as the best available evidence of the position of the original corner. Replaced 1" iron with  
standard county monument.


ROSCOMMON COUNTY  
PEER GROUP APPROVAL

DATE June 17, 1996

Marvin E. Myers  
Marvin E. Myers, P.S.  
County Surveyor

### C. Description of monument for corner and accessories established to perpetuate locating the position of the corner:

Mon. - Standard Roscommon County Monument stamped "MEM 31600 K-7"  
WIT: Set nail NW side 8" Cedar S40°W 67.45'  
Set nail SW side 12" Tw. Maple S54½°E 58.27'  
Set nail SE side 11" Maple clump N17°E 40.71'  
Set nail NE side 9" Maple N57°W 53.42'  
Face of corner fence post N33°E 32.30'  
Carsonite post South 8.00'±

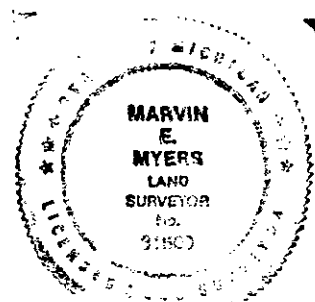

Signed by Marvin E. Myers

Date July 1, 1996

Surveyor's Michigan License No. 31600

FORM APPROVED BY MICHIGAN STATE BOARD OF PROFESSIONAL SURVEYORS, JAN. 28, 1971  
REVISED MAY 14, 1975  
REVISED JAN., 1983

1.000 2 Dirs