

90793181094

ROSCOMMON COUNTY REMONUMENTATION

STATE OF MICHIGAN
COUNTY OF ROSCOMMON

COMMISSION

LAND CORNER RECORDATION CERTIFICATE
Filing Requirement of Act 74, Mich. P.A. 1970

Dec 21 10 51 AM '93

For corners in

<u>ROSCOMMON</u> (County)	Located In:	Corner Code #
1. Public Land Survey	T <u>22N</u> R <u>4W</u>	<u>G-2</u>
	T _____ R _____	_____
	T _____ R _____	_____
	T _____ R _____	_____
2. Property Controlling in Section	S _____ T _____ R _____	_____
	S _____ T _____ R _____	_____
3. Miscellaneous Property in Sec.	S _____ T _____ R _____	_____
	S _____ T _____ R _____	_____
4. Lot No. _____, Recorded Plat _____		
5. Private Claims _____		

Robert J. ...
REGISTER OF DEEDS

**ROSCOMMON COUNTY
PEER GROUP APPROVAL
DATE 11/30/93**

**TO BE FILED IN LIBER 3 OF LAND CORNERS
Register of Deeds Stamp & File Number**

A	B	C	D	E	F	G	H	I	J	K	L	M
2	6	5	4	3	2	1						
3												
4	7	8	9	10	11	12						
5												
6	13	17	16	15	14	13						
7												
8	19	20	21	22	23	24						
9												
10	30	29	28	27	26	25						
11												
12	31	32	33	34	35	36						
13												

TIMOTHY L. LAPHAM, in a field survey on November, 19 93, do hereby certify that under requirements of P.A. 74, Michigan P.A. of 1970, the corner points mentioned in lines 1 and 2 above were in conformance with regulations and rules therefore as required in the current manual of survey instructions of the United States Department of the Interior, Bureau of Land Management or by a decree of a Court of Law and/or that the corner points mentioned in lines 3, 4 and 5 above were in conformance with the rules of the Michigan Board of Land Surveyors or by a Decree of a Court of Law; established, re-established, monumented, re-monumented, recovered, found as expressed below:

NOTE: Not more than 4 corners, all in the same town and range, may be recorded on this certificate.

A. Description of original monument and accessories and/or subsequent restoration:


G-2: 1852, A.CURTIS, POST, BEECH 10" N6W 17L, BEECH 7" S52E 25L; UNKNOWN, UNKNOWN, LCRC 2-255, CNR MAT, 3 WITS; 7/10/1975, L.CAVANAGH, SURVEY 309-522, COR MAT, NO WIT; 4/12/1977, L.CAVANAGH, SURVEY 331-452, NO COR MAT, 2 WITS; 4/12/1977, L.CAVANAGH, SURVEY 331-450, COR MAT, 3 WITS; 10/4/1977, L.CAVANAGH, SURVEY 338-564, NO COR MAT, 3 WITS; 6/1978, L.CAVANAGH, LCRC 1-137, COR MAT, 3 WITS; 11/1/1978, L.CAVANAGH, SURVEY 357-185, NO COR MAT, 3 WITS; 7/16/1981, L.CAVANAGH, SURVEY 393-252, COR MAT, 4 WITS; 12/28/1988, L.CAVANAGH, SURVEY NOT REC, COR MAT, 3 WITS; 12/4/1989, L.CAVANAGH, SURVEY NOT REC, NO COR MAT, 3 WITS; 5/6/1991, L.CAVANAGH, SURVEY 590-342, NO NEW INFO;

B. Description of corner evidence found and/or method applied in restoring or reestablishing corner:

G-2: FOUND 1/2"X24" PIPE IN MONUMENT BOX, DUG TO 3.5' NOTHING ELSE FOUND
16" BIRCH N55E 85.5' (DYING)
18" R. OAK S52E 92.0
20" R. OAK N67W 51.5
25" R. OAK S67W 92.0
ACCEPTED FOUND CORNER AS BEST EVIDENCE OF POSTION OF ORIGINAL CORNER.
THIS CORNER ESTABLISHED IN ROSCOMMON COUNTY REMONUMENTATION PROGRAM.
SEE DOSSIER FOR DETAILED REPORT.

C. Description of monument for corner and accessories established to perpetuate locating the position of the corner:

G-2: SET 2" X 21" CAST IRON MONUMENT WITH BRASS ROSCOMMON COUNTY PLATE IN MONUMENT BOX
AZ 130° 92.38' SPIKE NE FACE 26" OAK
AZ 296° 51.77' SPIKE SW FACE 26" OAK
AZ 54° 89.50' SPIKE SE FACE 8" TWIN OAK
AZ 240° 52.38' SPIKE NE FACE 12" POPLAR

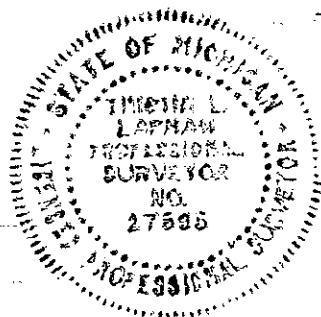

Signed by *Timothy L. Lapham* Date 12/20/93

Surveyor's Michigan License No. 27595

Date 11/30/93 Peer Group Approved