

4618

APR 07 1998

LAND CORNER RECORDATION CERTIFICATE
Filing Requirement of Act 74, Mich P.A. 1970

For corners in
Roscommon County

Located in: Corner Code #

1. Public Land Survey

T23N R 2W B-1
T24N R2W B-13
T R
T R

SECTION
STATE OF MICHIGAN
ROSCOMMON COUNTY
RECORDED

11 JUL 97 4:10 P.M.

ROBERT W. SMITH
REGISTER OF DEEDS

I, Larry L. Cavanagh, in a field survey June 20, 1997, do hereby certify that under requirements of P.A. 74, Michigan P.A. of 1970, the corner points mentioned in line 1 above was in conformance with regulations and rules therefore as required in the current manual of survey instructions of the United States Department of the Interior, Bureau of Land Management or by a decree of a Court of Law; established, re-established, monumented, recovered, found as expressed below:

Register of Deeds Stamp & File Number

	A	B	C	D	E	F	G	H	I	J	K	L	M
2	5		5		4		3		2		1		
3													
4	7		8		9		10		11		12		
5													
6	18		17		16		15		14		13		
7													
8	19		20		21		22		23		24		
9													
10	30		29		28		27		26		25		
11													
12	31		32		33		34		35		36		
13													

A. Description of original monument and accessories and/or subsequent restoration:

SET POST BY WILLIAM BURT 1852
WIT: TAM 5° N82°E 194
DO 6° N22°W 89

GLENN A FAUSER RLS, 18557, L646, P172,
1992
FD IRON PIPE BRASS CAP DEPT OF
CONSERVATION
NO WITNESSES

NORMAN C. CALDWELL RLS 12018, 1966
FD 1 1/4" PIPE IN CONC. & POST
(NOT SHOWN ON SCHAAF RECORD)
SET REGULATION CONSERVATION DEPT. CAP
& PIPE IN OLD PIPE, WHICH IS BELOW WATER
& NEW 4" BY 4" POST
CORNER IS 225 FEET SOUTH OF CENTERLINE E-W
ROAD IN MARSH
NO AVAILABLE WITNESSES

CARL F. ROSER RLS 12028, 1995
LCRC 1995 NO LIBER AND PAGE
FD CONSERVATION DEPT MON.
NO WITNESSES

LCRC LIBER 2, PAGE 498 (1972)
DNR CAP & PIPE
NEW 4"X4" CEDAR POST
SET 225' SOUTH OF E-W ROAD

B. Description of corner evidence found and/or method applied in restoring or reestablishing corner:

FOUND CONSERVATION DEPT. MONUMENT
NO WITNESSES


C. Description of monument for corner and accessories established to perpetuate locating the position of the corner:

CONSERVATION DEPT MONUMENT LEFT IN PLACE
WIT: NAIL & TAG IN 24" NORWAY S28°E 381.21'
NAIL & TAG IN POWER POLE N38°E 253.07
NAIL & TAG IN POWER POLE N31°W 229.11'
CARSONITE POST 1.3 SOUTH

THE BEST AVAILABLE EVIDENCE OF THE POSITION OF THE ORIGINAL CORNER.

ROSCOMMON COUNTY
PEER GROUP APPROVAL
DATE July 8, 1997

Marvin E. Myers
Marvin E. Myers, P.S.
County Surveyor

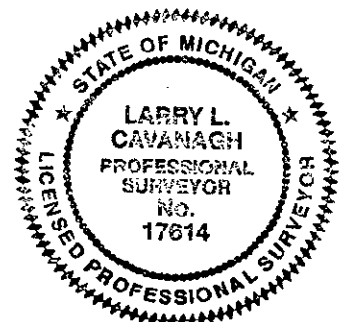

Signed by *Larry L. Cavanagh*
Surveyor's Michigan License NO. 17614

Date July 9, 1997

FORM APPROVED BY MICHIGAN STATE BOARD OF LAND SURVEYORS, JAN 28, 1971
REVISED MAY 14, 1975
REVISED JAN., 1983

LIBER 3 PAGE 411