

For corners in
ROSCOMMON
(County)

Located In:

Corner Code ~~≠~~

- | | | | | | |
|------------------------------------|---|-----|---|----|-----|
| 1. Public Land Survey | T | 23N | R | 3W | H-2 |
| | T | | R | | |
| | T | | R | | |
| | T | | R | | |
| 2. Property Controlling in Section | S | 2 | T | R | 15 |
| | S | 2 | T | R | 11 |
| 3. Miscellaneous Property in Sec. | S | | T | R | |
| | S | | T | R | |

Register of Deeds Stamp & File Number

4. Lot No. _____, Recorded Plat _____
5. Private Claims _____

I, CARL R. JOHNSON, in a field survey on JUNE 5, 1991, do hereby certify that under requirements of P.A. 74, Michigan P.A. of 1970, the corner points mentioned in lines 1 and 2 above were in conformance with regulations and rules therefore as required in the current manual of survey instructions of the United States Department of the Interior, Bureau of Land Management or by a decree of a Court of Law and/or that the corner points mentioned in lines 3, 4 and 5 above were in conformance with the rules of the Michigan Board of Land Surveyors or by a Decree of a Court of Law; established, re-established, monumented, re-monumented, recovered, found as expressed below:

NOTE: Not more than 4 corners, all in the same town and range, may be recorded on this certificate.


A. Description of original monument and accessories and/or subsequent restoration:		
H-2	15	11

- B. Description of corner evidence found and/or method applied in restoring or reestablishing corner:**

H-2	15	11
SET AT COMPUTED INTERSECTION OF 1/4 LINES	SET BY STANDARD PROCEDURE FOR SUBDIVISION OF A SECTION.	SET BY STANDARD PROCEDURE FOR SUBDIVISION OF A SECTION.

- C. Description of monument for corner and accessories established to perpetuate locating the position of the corner:**

H-2			15			11		
CENTER OF SE. 3			W1/8 COR. ON S. LINE SEC. 2			CENTER OF SW1/4 SEC. 2		
DNR MON.			5/8" BAR W/CAP			5/8" BAR W/CAP		
DOUBLE OAK 24"	N87E	28.10 FT.	TWIN OAK 10"	N36E	21.83 FT.	OAK 16"	N48W	12.15 FT.
W PINE 5"	S27E	60.75 FT.	OAK 10"	N26W	39.20 FT.	OAK 18"	N16E	37.25 FT.
R. OAK 6"	S33W	81.23 FT.	OAK 6"	S25W	43.40 FT.	OAK 8"	S51E	16.23 FT.
CEDAR POST	EAST	8.5 FT.	TWIN OAK 8"	S59E	33.92 FT.	OAK 10"	S08W	29.20 FT.

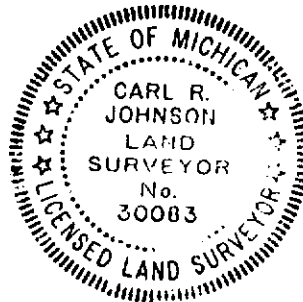

Signed by Clark J. T. Date 3/17/92

Surveyor's Michigan License No. 30083

FORM APPROVED BY MICHIGAN STATE BOARD OF LAND SURVEYORS, JAN. 26, 1971
REVISED MAY 14, 1975
REVISED JAN., 1983