

**SURVEY &
ROSCOMMON COUNTY MONUMENTATION
PEER GROUP APPROVAL**

DATE APR 24 1995

8282

**LAND CORNER RECORDATION CERTIFICATE
COMMISSION**
Filing Requirement of Act 74, Mich. P.A. 1970

STATE OF MICHIGAN
ROSCOMMON COUNTY
RECORDED

10 NOV 94 3:27 P.M.

ROBERT W. SMITH
REGISTER OF DEEDS

**ROSCOMMON COUNTY
PEER GROUP APPROVAL**
DATE 9-15-94

Register of Deeds Stamp & File Number

For corners in

Roscommon
(County)

Located In:

Corner Code =#

1. Public Land Survey	T	23N	R	4W	E - 4
	T		R		
	T		R		
	T		R		
2. Property Controlling in Section	S		T	R	
	S		T	R	
3. Miscellaneous Property in Sec.	S		T	R	
	S		T	R	

4. Lot No. _____, Recorded Plat _____
5. Private Claims _____

I, Marvin E. Myers, in a field survey on September 8, 19 94, do hereby certify that under requirements of P.A. 74, Michigan P.A. of 1970, the corner points mentioned in lines 1 and 2 above were in conformance with regulations and rules therefore as required in the current manual of survey instructions of the United States Department of the Interior, Bureau of Land Management or by a decree of a Court of Law and/or that the corner points mentioned in lines 3, 4 and 5 above were in conformance with the rules of the Michigan Board of Land Surveyors or by a Decree of a Court of Law; established, re-established, monumented, re-monumented, recovered, found as expressed below:

NOTE: Not more than 4 corners, all in the same town and range, may be recorded on this certificate.

A. Description of original monument and accessories and/or subsequent restoration:



GLO-Artemas Curtis
Mon-Post
WIT: 12" Aspen N50°E 234 lks.
10" Aspen S80°E 175 lks.
S. side Muskegon River N29.46 chs.

B. Description of corner evidence found and/or method applied in restoring or reestablishing corner:
No evidence of original monument or subsequent restoration was found.

Re-established by single proportionate measure between E-3 and E-5 and is accepted as a careful and faithful re-establishment of the position of the corner.

C. Description of monument for corner and accessories established to perpetuate locating the position of the corner:

Mon-Set 3/4" IDx40 1/2" Galvanized Iron Pipe with cap stamped "MEM 31600" M.W. & O.L. position between E-3 & E-5
WIT: Set Wit. Tag & Nail in top of 3/4"x3"x24" Wood Stake N00°05'23"W 8.69'
Set Wit. Tag & Nail in top of 3/4"x3"x24" Wood Stake S80°33'42"W 9.82'
Set Wit. Tag & Nail in top of 3/4"x3"x24" Wood Stake S86°34'49"E 9.35'
Set Carsonite Post S06°37'16"W 3.41'
E-3 N00°14'46"W 2614.95'
E-5 S00°14'46"E 2614.95'
North edge Muskegon River N00°14'46"W 1994.00'

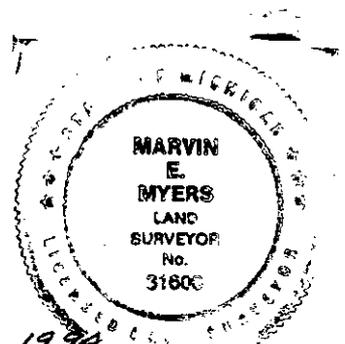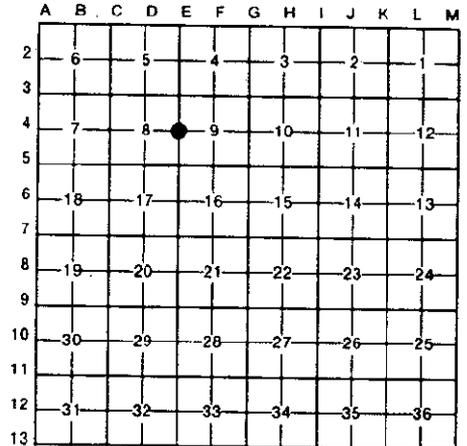

Signed by Marvin E. Myers

Date OCT 11, 1994

Surveyor's Michigan License No. 31600

FORM APPROVED BY MICHIGAN STATE BOARD OF LAND SURVEYORS, JAN. 28, 1971
REVISED MAY 14, 1975
REVISED JAN., 1993

LIBER 3 PAGE 104