
8276 SURVEY &

RE	MONUMENT		N== ==================================		re STATE OF I	VTPUTRAN		
			NER RECORDATION		DOCTOMEON			
For corners in	APR 2 4 1995	Filing Requ	irement of Act 74, I	ement of Act 74, Mich. P.A. 19		70 RECORDED		
Roscommon	,, COMMI SSI	Oppocated in:	gcated in: Corner Code =		10 NOV 94 3:26 P.M.			
1. Public Land Survey		T <u>23N</u> R <u>4W</u> T R				V. SMITH		
		T R			ROSCOMMON C	OUNTY		
O Duranti Oi		T R			PEER GROUP AF	PROVAL MEN		
Property Cor in Section		T R T R			DATE <u>9-15 -</u>	- 94		
3. Miscellaneou		T R		_				
Property in S	· -	T R		K	egister of Deeds Stam	p & File Number		
4. Lat No.	Recorded	l Plat	77.					
					- A B C D E F	GHIJKL		
o. ,a.c o.a			· · · · · · · · · · · · · · · · · · ·	·———	_ 2			
		•			3 1			
	•					 		
. Marvin E. Mv	era	. Sente	ember 8	. 94	4 - 7 - 4 - 9 - 9 -	101112-		
do harabu aartifutt	, in a rie	la survey on	A. of 1970, the corner poi	19	5			
in lines 1 and 2 at	nat unider requirement nove were in conform	SOLP A. 74, MICHIGAN P. Jance with regulations	and rules therefore as re	nts mentioned	6 18 17 16			
current manual of	survey instructions of	the United States Dec	partment of the Interior, B	ureau of Land	7			
Management or by	a decree of a Court of	Law and/or that the cor	mer points mentioned in I	ines 3. 4 and 5				
above were in conf	ormance with the rule	s of the Michigan Boar	d of Land Surveyors or by	a Decree of a	8 19 20 21	-1-22-1-23-1-24-		
Court of Law; es	tablished, re-establis	shed, monumented, re	e-monumented, recovere	ed, found as	9			
expressed below:				,	10 30 29 28	27 26 25		
NOTE: Not mor	re than 4 corners a	Ill in the same town	and range, may be re	corded	11			
	certificate.	iii iii tiic sailic town	Blid lalige, may be re	Colded				
On this t	ser (misale,				12 31 32 33	34 35 36		
A Description	-6 - mining				13			
		nt and accessories a	and/or subsequent res	toration:				
GLO-Artemas Cur Mon-Post	rtis 1852							
	ck N35°E 12 1ks.							
8" Tamara	ck S45°W 54 1ks.					•		
			•					
				-				
		•						
•			•					
					·	_		
•								
B. Description	of corner evidence	found and/or method	d applied in restoring o	or reestablishin	ig corner:			
Accepted inter of the origina	section of center l corner.	line roads to the	East and to the Sou	th as the bes	t available evidence	of the position		
			•					
	•				· ·			
				•		ı		
,				•				
•	•							
	*					•		
			•					
				4				

C. Description of monument for corner and accessories established to perpetuate locating the position of the corner.

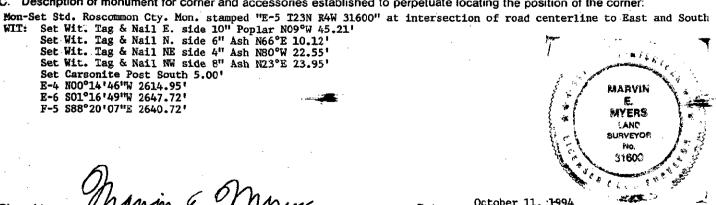

October 11, 1994

Surveyor's Michigan License No.

APPROVED BY MICHIGAN STATE BOARD OF LAND SURVEYORS, JAN. 28, 1971 REVISED MAY 14, 1975 REVISED JAN., 1983