

8284
ROSCOMMON COUNTY SURVEY &
REMONUMENTATION
PEER GROUP APPROVAL

DATE APR 24 1995 LAND CORNER RECORDATION CERTIFICATE
Filing Requirement of Act 74, Mich. P.A. 1970
COMMISSION

STATE OF MICHIGAN
ROSCOMMON COUNTY
RECORDED

For corners in

Roscommon	Located In:	Corner Code
(County)		
1. Public Land Survey	T <u>23N</u> R <u>4W</u>	<u>F - 7</u>
	T _____ R _____	_____
	T _____ R _____	_____
	T _____ R _____	_____
2. Property Controlling	S _____ T _____ R _____	_____
in Section	S _____ T _____ R _____	_____
3. Miscellaneous	S _____ T _____ R _____	_____
Property in Sec.	S _____ T _____ R _____	_____

10 NOV 94 3:27 P.M.

ROBERT W. SMITH
REGISTER OF DEEDS

ROSCOMMON COUNTY
PEER GROUP APPROVAL

DATE 9-15-94

Register of Deeds Stamp & File Number

4. Lot No. _____, Recorded Plat _____
5. Private Claims _____

I, Marvin E. Myers, in a field survey on SEPT 8, 19 94,
do hereby certify that under requirements of P.A. 74, Michigan P.A. of 1970, the corner points mentioned
in lines 1 and 2 above were in conformance with regulations and rules therefore as required in the
current manual of survey instructions of the United States Department of the Interior, Bureau of Land
Management or by a decree of a Court of Law and/or that the corner points mentioned in lines 3, 4 and 5
above were in conformance with the rules of the Michigan Board of Land Surveyors or by a Decree of a
Court of Law; established, re-established, monumented, re-monumented, recovered, found as
expressed below:

**NOTE: Not more than 4 corners, all in the same town and range, may be recorded
on this certificate.**

A. Description of original monument and accessories and/or subsequent restoration:


GLO-Artemas Curtis 1852	Larry Cavanagh 6-1-78
Mon-Set Post	Mon- $\frac{1}{2}$ " Steel bar
WIT: 6" Tamarack N05°E 6 lks.	WIT: None
6" Tamarack S20°E 5 lks.	RCRC L.2, pg.416 LCRC
MDOT-Ward Abrahamson Nov. 1958	Mon- $\frac{1}{2}$ " Steel bar
Mon-Fd. $\frac{1}{2}$ " Steel Rod	WIT: NW Sec. Cor. West 2579.78'
WIT: None (marsh)	
MDOT-8-5-60	
Mon- $\frac{1}{2}$ " Steel Bar	
WIT: None (marsh)	

B. Description of corner evidence found and/or method applied in restoring or reestablishing corner:

Monument found $\frac{1}{2}$ " bar along side 2"x2" Hub; and accepted as the best available evidence of the position of the
original corner.

C. Description of monument for corner and accessories established to perpetuate locating the position of the corner:

Mon-Set 3/4" IDx48" Galvanized iron pipe and cap stamped "MEM 31600" over Fd. $\frac{1}{2}$ " bar
WIT: Set Carsonite post East 3'
Fd. conc. Mon on E'y Old US 27 S89°10'07"E 747.66'
Fd. $\frac{1}{2}$ " pipe at SW Cor. AGNES SUB (1/8 cor) S89°10'32"E 1395.46'
Set nail W'y shoulder Old US 27 N69°34'57"E 751.88'

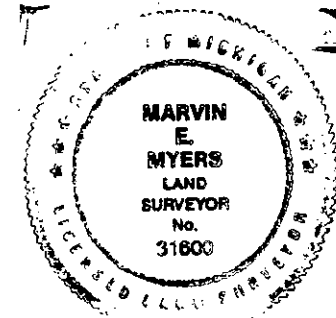

Signed by Marvin E. Myers

Date OCT 10, 1994

Surveyor's Michigan License No. 31600

FORM APPROVED BY MICHIGAN STATE BOARD OF LAND SURVEYORS, JAN. 28, 1971
REVISED MAY 14, 1975
REVISED JAN., 1983

LIBER 3 PAGE 106