

8278

# ROSCOMMON COUNTY SURVEY & PEER GROUP APPROVAL REMONUMENTATION

DATE APR 24 1995 LAND CORNER RECORDATION CERTIFICATE  
Filing Requirement of Act 74, Mich. P.A. 1970

STATE OF MICHIGAN  
ROSCOMMON COUNTY  
RECORDED

For corners in

COMMISSION  
Located In:

Corner Code ≠

10 NOV 94 3:26 P.M.

ROBERT W. SMITH  
REGISTER OF DEEDS

ROSCOMMON COUNTY  
PEER GROUP APPROVAL *MEM*  
DATE 9-15-94

Register of Deeds Stamp &amp; File Number

Roscommon  
(County)

- |                         |   |            |   |           |               |
|-------------------------|---|------------|---|-----------|---------------|
| 1. Public Land Survey.  | T | <u>23N</u> | R | <u>4W</u> | <u>G - 10</u> |
|                         | T |            | R |           |               |
|                         | T |            | R |           |               |
|                         | T |            | R |           |               |
| 2. Property Controlling | S |            | T | R         |               |
| in Section              | S |            | T | R         |               |
| 3. Miscellaneous        | S |            | T | R         |               |
| Property in Sec.        | S |            | T | R         |               |
4. Lot No. \_\_\_\_\_, Recorded Plat \_\_\_\_\_
5. Private Claims \_\_\_\_\_

I, Marvin E. Myers, in a field survey on September 12, 19 94,  
do hereby certify that under requirements of P.A. 74, Michigan P.A. of 1970, the corner points mentioned  
in lines 1 and 2 above were in conformance with regulations and rules therefore as required in the  
current manual of survey instructions of the United States Department of the Interior, Bureau of Land  
Management or by a decree of a Court of Law and/or that the corner points mentioned in lines 3, 4 and 5  
above were in conformance with the rules of the Michigan Board of Land Surveyors or by a Decree of a  
Court of Law; established, re-established, monumented, re-monumented, recovered, found as  
expressed below:

**NOTE:** Not more than 4 corners, all in the same town and range, may be recorded  
on this certificate.

## A. Description of original monument and accessories and/or subsequent restoration:

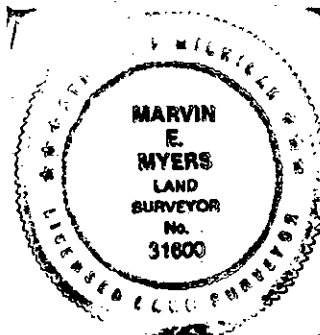
GLO-Artemas Curtis 1852	Henning/Ostling Dec. 1949
Mon-Set Post	Mon-In Lake
WIT: 10" W.Pine N25°W 8 lks.	WIT: Conc. Mon. West 24.80'
6" W.Birch S25°W 12 lks.	Jas. E. Richardson date unknown
Henning/Ostling Aug. 1945	Mon-In Lake
Mon-In Lake	WIT: Axle shaft in conc. S89°12'W 21.04'
WIT: Conc. Mon. S89°12'W 24.80'	Larry Cavanagh Oct. 6, 1987
Ostling July 31, 1948	Mon-In Lake
Mon-In Lake	WIT: G-9 shown as N00°16'W 2635.10'
WIT: Conc. Mon. West 24.80'	
South to G-11 shown as 2688.40'	
North to G-9 shown as 2636.60'	

## 3. Description of corner evidence found and/or method applied in restoring or reestablishing corner:

Monument not found; corner in Houghton Lake. Traversed between G-11 and G-9 and tied in corner reference of record.  
Accepted the computed position of record as the best available evidence of the position of the original corner.

## 3. Description of monument for corner and accessories established to perpetuate locating the position of the corner:

Mon-None Set  
WIT: Fd ½" Bar & Cap #17614 N38°19'52"W 56.49'  
Fd ½" bar S68°26'24"E 43.03'  
G-9 N01°31'02"E 2635.10'  
G-11 S-1°31'02"W 2688.76'

Signed by Marvin E. MyersDate Oct 10, 1994Surveyor's Michigan License No. 31600

FORM APPROVED BY MICHIGAN STATE BOARD OF LAND SURVEYORS, JAN. 28, 1971  
REVISED MAY 14, 1975  
REVISED JAN., 1983

LIBER 3 PAGE 100