

9259

FEB 19 1994

COMMISSION

## ROSCOMMON COUNTY REMONUMENTATION

## LAND CORNER RECORDATION CERTIFICATE

Filing Requirement of Act 74, Mich. P.A. 1970

STATE OF MICHIGAN  
COUNTY OF ROSCOMMON

Dec 28 10 47 AM '93

For corners in

Roscommon

(County)

Located In:

Corner Code =#

- |                         |   |    |   |   |   |       |
|-------------------------|---|----|---|---|---|-------|
| 1. Public Land Survey   | T | 24 | R | 1 | W | A - 2 |
|                         | T |    | R |   |   |       |
|                         | T |    | R |   |   |       |
|                         | T |    | R |   |   |       |
| 2. Property Controlling | S |    | T |   | R |       |
| in Section              | S |    | T |   | R |       |
| 3. Miscellaneous        | S |    | T |   | R |       |
| Property in Sec.        | S |    | T |   | R |       |

ROSCOMMON COUNTY  
PEER GROUP APPROVAL  
DATE 12-14-93

Register of Deeds Stamp &amp; File Number

4. Lot No. \_\_\_\_\_, Recorded Plat \_\_\_\_\_
5. Private Claims \_\_\_\_\_

I, Frank J. Arleth, in a field survey on December, 19 93,  
do hereby certify that under requirements of P.A. 74, Michigan P.A. of 1970, the corner points mentioned  
in lines 1 and 2 above were in conformance with regulations and rules therefore as required in the  
current manual of survey instructions of the United States Department of the Interior, Bureau of Land  
Management or by a decree of a Court of Law and/or that the corner points mentioned in lines 3, 4 and 5  
above were in conformance with the rules of the Michigan Board of Land Surveyors or by a Decree of a  
Court of Law; established, re-established, monumented, re-monumented, recovered, found as  
expressed below:

**NOTE: Not more than 4 corners, all in the same town and range, may be recorded  
on this certificate.**

- A. Description of original monument and accessories and/or subsequent restoration:


William Burt Set Post, May 1839  
S. Pine 9" N38°E 52 lks.  
S. Pine 5" S20°E 25 lks.

- B. Description of corner evidence found and/or method applied in restoring or reestablishing corner:

1946 Henning Found RR Iron in corner in centerline of Old N-S Road & old fence Line East  
of position. Henning Wit: are destroyed November 1993.  
Concrete Mon. 33.0 feet West of Corner, RR Iron under blacktop. Corner used by Arleth  
surveys for parcels in Section 6, T24N, R1W and various Parcel surveys in Section 1,  
T24N, R1W. Concrete Mon. was placed 33.0 feet West of Corner position for the Plat  
of DEERHEART WOODS ANNEX ( 7/8/59) Liber 4, page 32

- C. Description of monument for corner and accessories established to perpetuate locating the position of the corner:

Sit Roscommon county Std. Mon stamped M-2  
Nail & tag in 12" J. Pine N67°W 49.91  
Nail & tag in 14" J. Pine N51°E 75.87  
Nail & tag in 6" J. Pine S64°E 96.75  
Nail & tag in 5" J. Pine S42°W 85.81  
Plat concrete Mon. West 33.0  
½" bar East 33.0  
Place carsonite post 33.0 West on North side of mon.

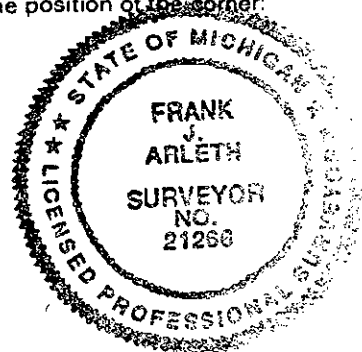

Signed by

Date

27 DEC 93

Surveyor's Michigan License No.

21266

Date December 14, 1993

Peer Group Approved

LIBER

3 PAGE 85