## LAND CORNER RECORDATION CERTIFICATE Filing Requirement of Act 74, Mich. P.A. 1970

F	corners	:

	ROSCU IMMUN (County)	·	Located In:	Corner Code 44
1.	Public Land Survey		Ť R	
			T R	
			T R	
			T R	
2.	Property Controlling	S	T R	
	in Section	s	T R.	
3.	Miscellaneous	S .34	T 24N R 2W	9, I-12; 9, I-12
	Property in Sec.	S 34	T 24N R 2W	2. I-11

Register of Deeds Stamp & File Number

 
4. Lot No.


, Recorded Plat

5. Private Claims

I. Carl R. Johnson , in a field survey on May 28, do hereby certify that under requirements of P.A. 74, Michigan P.A. of 1970, the corner points mentioned in lines 1 and 2 above were in conformance with regulations and rules therefore as required in the current manual of survey instructions of the United States Department of the Interior, Bureau of Land Management or by a decree of a Court of Law and/or that the corner points mentioned in lines 3, 4 and 5 above were in conformance with the rules of the Michigan Board of Land Surveyors or by a Decree of a Court of Law; established, re-established, monumented, re-monumented, recovered, found as expressed below:

NOTE: Not more than 4 corners, all in the same town and range, may be recorded on this certificate.



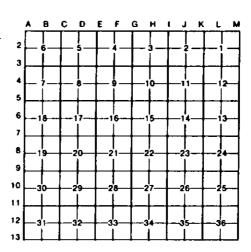

- B. Description of corner evidence found and/or method applied in restoring or reestablishing corner:
  - 9, I-12 Set corner by standard survey procedure for subdivision of sections.
  - 9, I-12 Set by standard survey procedure for subdivision of sections.
  - 2, I-11 Set by standard survey procedure for subdivision of sections.
- C. Description of monument for corner and accessories established to perpetuate locating the position of the corner:

Set 5/8" bar w/cap N88°32'06"E 165.14' from E 1/16 corner on N. side of section.

