

LAND CORNER RECORDATION CERTIFICATE

Filing Requirement of Act 74, Mich. PA 1970

For Corners In:
Roscommon
(County)

Located In

Corner Code #

1. Public Land Survey	T	<u>24N</u>	R	<u>2W</u>	<u>D-9</u>
	T	<u>24N</u>	R	<u>2W</u>	<u>E-9</u>
2. Property Controlling in Section	S		T		
	S		T		
3. Miscellaneous Property in Section	S		T		
	S		T		


4. Lot No: _____ Recorded Plat: _____

5. Private Claims: _____

I, Carl T. Kiiskila, in a field survey on June 21, 2006 do hereby state that under requirements of PA 74, Michigan PA of 1970, the corner points mentioned in lines 1 and 2 above were in conformance with regulations and rules therefore as required in the current manual of survey instructions of the United States Department of the Interior, Bureau of Land Management or by a decree of a Court of Law and/or that the corner points mentioned in lines 3, 4 and 5 above were in conformance with the rules of the Michigan Board of Land Surveyors or by a Decree of a Court of Law; established, re-established, monumented, recovered, found as expressed below:

NOTE: Not more than 2 corners, all in the same town and range, may be recorded on this certificate.

Register of Deeds Stamp & File Number

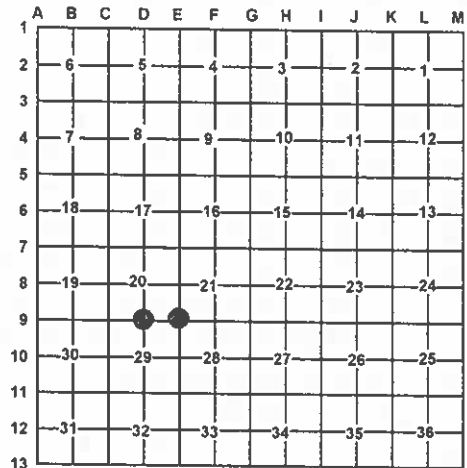

A. Description of original monument and accessories and/or subsequent restoration:

D-9 G.L.O. 1852 Wm. Burt set quarter section post
Y. Pine 20" N50°W 6 links
Y. Pine 18" S40°E 18 links

E-9 G.L.O. 1852 Wm. Burt Set post for corner
Wit: S. Pine 10" S56°E 9 links
S. Pine 8" N24°W 20 links

October 1929 G.F. DeLaMater R.L.S. #693 found one Gov. B. set cedar post
Wits: W. Oak 18" S44°W 63.2'
Y. Pine 12" N35°W 35.8'

October 1929 G.F. DeLaMater established corner and set a cedar post. Wit: Mound of earth N45°E 50.0'
Mound of earth S45°W 50.0'

B. Description of corner evidence found and/or method applies in restoring or re-establishing corner:

D-9 Found a 3" X 16" hole with remains of G.F. DeLaMater's stake. Also found the stump of one original bearing tree Y. Pine 20" N50°W 6 links. Both of G.F. DeLaMater's new bearing trees were also found.

E-9 Set a 1" X 32" pipe with standard DNR cap from G.F. DeLaMater's two witness mounds.

C. Description of monument for corner and accessories established to perpetuate locating the position of the corner:

D-9 Set 1" X 32" pipe with Standard DNR aluminum cap.
Wit: 16" Y. Pine stump N70°E 21.00'
24" Y. Pine stump N38°W 4.2'
22" R. Pine N32°W 35.75'
8" Maple N83°E 21.12'
6" W. Pine N24°E 40.18'
24" Oak S56°W 64.10'
Blue Carsonite Post North 1'±

E-9 Set 1" X 32" pipe with standard DNR aluminum cap.
Wit: Dirt Mound N45°E 50.00'
Dirt Mound S45°W 50.00'
9" Oak N20°E 62.15'
10" J. Pine N62°E 29.95'
8" J. Pine S10°E 37.39'
14" Oak N46°W 32.38'
Blue Carsonite Post North 1'±

Signed by:

Carl T. Kiiskila

Date:

7/18/06

Surveyor's Michigan License No.:

33981

