

APR 24 1995

ROSCOMMON COUNTY REMONUMENTATION  
LAND CORNER RECORDATION CERTIFICATE  
Filing Requirement of Act 74, Mich. P.A. 1970

STATE OF MICHIGAN  
ROSCOMMON COUNTY  
RECORDED

For corners in  
Roscommon

(County)

Located In:

Corner Code ##

15 NOV 94 9:06 A.M.

ROBERT W. SMITH  
REGISTER OF DEEDS

1. Public Land Survey T 24 R 2 W C-7  
T      R       
T      R       
T      R       
T      R       
2. Property Controlling S      T      R       
in Section S      T      R       
3. Miscellaneous S      T      R       
Property in Sec. S      T      R

TO BE FILED IN LIBER 3 OF LAND CORNERS

Register of Deeds Stamp & File Number

4. Lot No.           , Recorded Plat             
5. Private Claims

	A	B	C	D	E	F	G	H	I	J	K	L	M
2	6	5	4	3	2	1							
3													
4	7	8	9	10	11	12							
5													
6	18	17	16	15	14	13							
7													
8	19	20	21	22	23	24							
9													
10	30	29	28	27	26	25							
11													
12	31	32	33	34	35	36							
13													

I, Frank J. Arleth, in a field survey on November, 19 94,  
do hereby certify that under requirements of P.A. 74, Michigan P.A. of 1970, the corner points mentioned  
in lines 1 and 2 above were in conformance with regulations and rules therefore as required in the  
current manual of survey instructions of the United States Department of the Interior, Bureau of Land  
Management or by a decree of a Court of Law and/or that the corner points mentioned in lines 3, 4 and 5  
above were in conformance with the rules of the Michigan Board of Land Surveyors or by a Decree of a  
Court of Law, established, re-established, monumented, re-monumented, recovered, found as  
expressed below:

**NOTE: Not more than 4 corners, all in the same town and range, may be recorded  
on this certificate.**

A. Description of original monument and accessories and/or subsequent restoration:

Post Brink 1837 - Burt 1852 1953 Henning found 4" pipe  
S. pine 8" N33°W 03 in section subdivision of  
S. pine 7" S73°E 31 section 18

1929 Delamater Set 4" pipe in corner Corner destroyed by R.C.R. C. in 1960 and replaced  
15" B. Oak S40°E 124.0 by D.N. R. with 4" pipe filled with concrete &  
18" B. Oak N40°W 67.9 Brass cap. Wit: 5" N. pine N33°E 89.39  
24" B. oak N31°E 44.1 4" J. pine N12°W 68.45  
6" J. pine N38°W 73.32


B. Description of corner evidence found and/or method applied in restoring or reestablishing corner:

Arleth found D.N. R. monument, 4" pipe filled with concrete & brass cap.  
Found Wit: 5" N. pine N33°E 89.39'  
4" J. pine N12°W 68.45'  
Pine N 38°W destroyed.

C. Description of monument for corner and accessories established to perpetuate locating the position of the corner:

USED D. N. R. Monument in pav't box. C-7  
N & T 14" N. pine N37°E 89.23  
N & T 10 J. pine N10°W 62.41  
N & T 10" W. pine S54°E 35.86  
N & T 16" J. pine S35°W 68.30  
N 7 T 12" B. Oak S67°W 68.0  
Carsonite survey post set S67°W 35.0'

Corner is 20' South of centerline of      & W Road  
and in centerline of road     

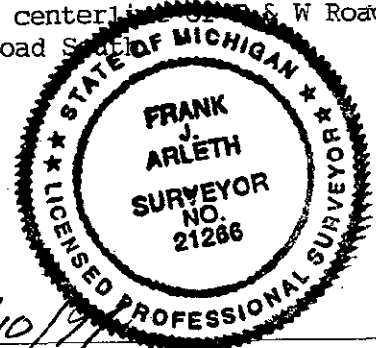

Signed by Frank J. Arleth 21266 P.S.

Date 11/10/94

Surveyor's Michigan License No.     

DATE 10/20/94

Peer Group Approved

FORM APPROVED BY MICHIGAN STATE BOARD OF LAND SURVEYORS, JAN. 28, 1971  
REVISED MAY 14, 1975  
REVISED JAN., 1983

**LIBER 3 PAGE 142**