

LAND CORNER RECORDATION CERTIFICATE  
Filing Requirement of Act 74, Mich. P.A. 1970

For corners in

Roscommon Located In: Corner Code #  
(County)  
1. Public Land Survey T 24N R 4W I-10  
2. Property Controlling T R  
in Section S 27 T 24N R 4W 5  
3. Miscellaneous S T R  
Property in Sec. S T R

Register of Deeds Stamp & File Number

4. Lot No. , Recorded Plat

5. Private Claims

I, Carl T. Kiiskila, in a field survey on July 07, 19 98 do hereby state that under requirements of P.A. 74, Michigan P.A. of 1970, the corner points mentioned in lines 1 and 2 above were in conformance with regulations and rules therefore as required in the current manual of survey instructions of the United States Department of the Interior, Bureau of Land Management or by a decree of a Court of Law and /or that the corner points mentioned in lines 3, 4 and 5 above were in conformance with the rules of the Michigan Board of Land Surveyors or by a Decree of a Court of Law; established, re-established, monumented, recovered, found as expressed below:

NOTE: Not more than 2 corners, all in the same town and range, may be recorded on this certificate.

	A	B	C	D	E	F	G	H	I	J	K	L	M
1													
2	6		5		4		3		2		1		
3													
4	7		8		9		10		11		12		
5													
6	18		17		16		15		14		13		
7													
8	19		20		21		22		23		24		
9													
10	30		29		28		27		26		25		
11													
12	31		32		33		34		35		36		
13													

A. Description of original monument and accessories and/or subsequent restoration:

I-10 GLO - 20" Yellow Pine for quarter section corner.  
Witness: Yellow Pine 20" N 86° W 21 links  
Yellow Pine 16" N 87° E 40 links

5 - This position was not established during the original government survey.

B. Description of corner evidence found and/or method applied in restoring or reestablishing corner:

I-10 Found and accepted a 1/2" pipe as used by G. Henning, RLS, Larry Cavanagh, PS #17614, and others for surveys in the area.

5 - Found and accepted a 1/2" bar for the Northwest Corner of the Southwest Quarter of the Northeast Quarter of Section 27. This position fits standard BLM instructions for subdivision of a section.


C. Description of monument for corner and accessories established to perpetuate locating the position of the corner:

I-10 Found 1/2" iron pipe. Set 1" x 32" iron pipe with aluminum DNR monument cap and set carsonite marker post.  
Witness: Set nail in 5" twin Oak N 59° W 9.38'  
Set nail in 7" Oak N 1° E 34.28'  
Set nail in 3" White Pine N 88° E 37.57'  
Set nail in 10" Oak S 3° E 42.37'  
Centerline north-south trail road West 72' ±

5 - Found 1/2" iron bar. Set carsonite marker post.  
Witness: Set nail in 16" Cherry S 29° W 88.01'  
Set nail in 12" Oak N 74° W 34.08'  
Set nail in 24" Oak S 27° E 42.28'  
Set nail in power pole N 23° E 130.23'  
Found 1/2" iron pin South 4.51'  
Carsonite post set West 33'

Signed by Carl T. Kiiskila  
Surveyor's Michigan License No. 33981

Date 8-18-98

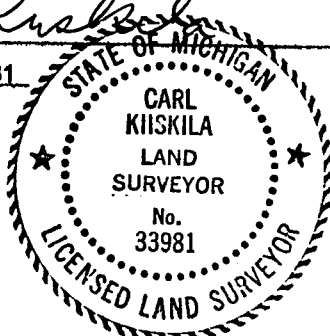

FORM APPROVED BY MICHIGAN STATE BOARD OF PROFESSIONAL SURVEYORS, JAN. 28, 1971  
REVISED MAY 14, 1976  
REVISED JAN., 1983  
REVISED OCT., 1985