

SAGINAW COUNTY REMONUMENTATION

LAND CORNER RECORDATION CERTIFICATE
Filing Requirement of Act 74, Mich. P.A. 1970

For corners in

Saginaw Located in: City of Saginaw, Corner Code #
(County) Saginaw Township

1. Public Land Survey T 12N R 4E K-6
T R
2. Property Controlling S T R
in Section S T R
3. Miscellaneous S T R
Property in Sec. S T R

4. Lot No. , Recorded Plat
5. Private Claims

I, Brian D Ferguson, in a field survey on September 3, 19 96 do hereby state that under requirements of P.A. 74, Michigan P.A. of 1970, the corner points mentioned in lines 1 and 2 above were in conformance with regulations and rules therefore as required in the current manual of survey instructions of the United States Department of the Interior, Bureau of Land Management or by a decree of a Court of Law and/or that the corner points mentioned in lines 3, 4 and 5 above were in conformance with the rules of the Michigan Board of Land Surveyors or by a Decree of a Court of Law; established, re-established, monumented, recovered, found as expressed below:

NOTE: Not more than 2 corners, all in the same town and range, may be recorded on this certificate.

A. Description of original monument and accessories and/or subsequent restoration:

K-6 Wood post set by Wampler, 1822.
LCRC L. 3, Pg. 169.
Plat L. 8, Pg. 31.
Survey L. 1577, Pg. 585.

B. Description of corner evidence found and/or method applied in restoring or reestablishing corner:

K-6 Found 2" city marker flush with asphalt surface.
Position agrees with City of Saginaw re-survey map.
Accepted by peer group as best available evidence of original corner.

C. Description of monument for corner and accessories established to perpetuate locating the position of the corner:

K-6 Epoxy Saginaw County Remon. cap to 2" city marker in monument box.
N10°E 43.28 N & S E face 26" elm.
S0°W 22.70 N & S W face power / light pole.
N40°W 58.06 N & S SW face 20" elm.
N65°E 60.19 SW corner concrete sidewalk.

Signed by Brian D Ferguson
Surveyor's Michigan License No. 26454

Date 9-27-96


MILDRED M. BODAK
REGISTER OF DEEDS
SAGINAW COUNTY MICH.

SEP 27 11 42 AM 1996

RECORDED & FILED

Liber 7 Page 59
Register of Deeds Stamp & File Number

	A	B	C	D	E	F	G	H	I	J	K	L	M
1													
2	6			5		4		3		2		1	
3													
4	7			6		5		4		3		2	1
5													
6	18			17		16		15		14		13	
7													
8	19			20		21		22		23		24	
9													
10	30			29		28		27		26		25	
11													
12	31			32		33		34		35		36	
13													

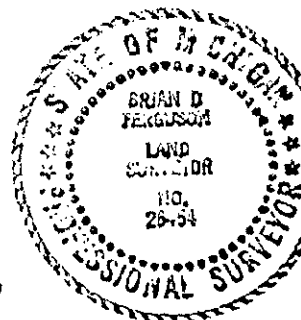

MAY 13 1997