

REMONUMENTATION
APR 10 1995
COMMISSION

LIBER 1 PAGE 488

LAND CORNER RECORDATION CERTIFICATE
Filing Requirement of Act 74, Mich. P.A. 1970

RECEIVED FOR RECORD

94 DEC 16 AM 9:40

LIBER NO. 1 PAGE NO. 488
ESTHER LEE
REGISTER OF DEEDS
SANILAC CO., MICHIGAN

For corners in
Sanilac
(County)

Located In:

Corner Code #/

1. Public Land Survey T 10NR14E D - 13
T R
T R
T R
2. Property Controlling S T R
in Section S T R
3. Miscellaneous S T R
Property in Sec. S T R
4. Lot No. , Recorded Plat
5. Private Claims

Register of Deeds Stamp & File Number

I, John A Milletics, in a field survey on Aug 14, 19 94,
do hereby certify that under requirements of P.A. 74, Michigan P.A. of 1970, the corner points mentioned
in lines 1 and 2 above were in conformance with regulations and rules therefore as required in the
current manual of survey instructions of the United States Department of the Interior, Bureau of Land
Management or by a decree of a Court of Law and/or that the corner points mentioned in lines 3, 4 and 5
above were in conformance with the rules of the Michigan Board of Land Surveyors or by a Decree of a
Court of Law; established, re-established, monumented, re-monumented, recovered, found as
expressed below:

NOTE: Not more than 4 corners, all in the same town and range, may be recorded
on this certificate.

A. Description of original monument and accessories and/or subsequent restoration:

D - 13 GLO Notes
Set 1/2 Mile Post Sugar 14 N 36 1/2 W 17, Beech 9 N 16 E 31
Act 74 Form NONE
Act 132 Form Liber 4 Page 51
Unrecorded Surveys Dated 8-9-88, 4-20-91
Road Comm NONE
Drain Comm NONE


Approved Peer Board Meeting
Dec. 16, 1994 gn

B. Description of corner evidence found and/or method applied in restoring or reestablishing corner:

D - 13
S 1/4 Cor Section 32 T10N-R14E
Found 1/2" Iron Bar
S80°W 9.20 to the South leg of a Road Sign
N75°W 31.90 to a nail in a Wooden Fence Post
S60°W 54.00 to a nail in a Power Pole
N80°E 57.33 to a Road Sign
S70°E 82.00 to a Road Sign

C. Description of monument for corner and accessories established to perpetuate locating the position of the corner:

D - 13
S 1/4 Cor Section 32 T10N-R14E
Found 1/2" Iron Bar
S80°W 9.20 to the South Leg of a Road Sign
N75°W 31.90 to a nail in a wooden Fence Post
S60°W 54.00 to a nail in a Power Pole
N80°E 57.33 to a Road Sign
S70°E 82.00 to a Road Sign

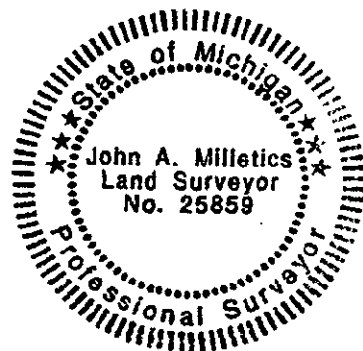

Signed by

John A Milletics

Date

Dec. 7, 1994

Surveyor's Michigan License No.

25859