

RECEIVED FOR RECORD

98 DEC -1 AM 9:10

REMONUMENTATION

LAND CORNER RECORDATION CERTIFICATE
Filing Requirement of Act 74, Mich. P.A. 1970

For corners in

Sanilac

(County)

Located in:

Corner Code #

1. Public Land Survey

T13NR15E

A-11

T R

T R

T R

T R

2. Property Controlling
in Section

S

T R

S

T R

3. Miscellaneous

S

T R

Property in Sec.

S

T R

4. Lot No. _____, Recorded Plat _____

5. Private Claims _____

I, John A. Millettics, in a field survey on Oct 12, 19 98 do hereby state that under requirements of P.A. 74, Michigan P.A. of 1970, the corner points mentioned in lines 1 and 2 above were in conformance with regulations and rules therefore as required in the current manual of survey instructions of the United States Department of the Interior, Bureau of Land Management or by a decree of a Court of Law and/or that the corner points mentioned in lines 3, 4 and 5 above were in conformance with the rules of the Michigan Board of Land Surveyors or by a Decree of a Court of Law; established, re-established, monumented, recovered, found as expressed below:

NOTE: Not more than 2 corners, all in the same town and range, may be recorded on this certificate.

A. Description of original monument and accessories and/or subsequent restoration:

A-11 GLO Notes - B. Ash 8 N25W 21; Elm 20 S46W 16
Old Survey Liber - None
L.C.R.C. - None
Act 132 - Liber 4 Page 516
Unrecorded survey dated 6-22-78 (Edmands Eng)
Road Comm. None
Recorded Plat Liber 2 Page 13 Showing Corner

B. Description of corner evidence found and/or method applied in restoring or reestablishing corner:

A - 11

NW Corner Section 31 T13N-R15E

Found Mounment Box in place with 5/8" iron bar in box

Accepted as best evidence

North 2648.22 feet to the W 1/4 Corner Section 30

South 2648.20 feet to the W 1/4 Corner Section 31

C. Description of monument for corner and accessories established to perpetuate locating the position of the corner:

A-11

NW Corner Section 31 T13N-R15E

Mounment box with 5/8" iron bar in Box

S50°E 48.30 to a nail in a Power Pole

S45°W 61.00 to a nail in a Power Pole

N50°W 51.00 to a nail in a Light Pole

N50°E 60.90 to a nail in a Power Pole

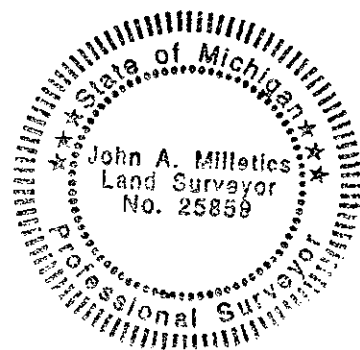
North 2648.22 feet to the W 1/4 Corner Section 30

South 2648.20 feet to the W 1/4 Corner Section 31

LIBER NO. 2 PAGE NO. 270MICHELE VANNORMAN
REGISTER OF DEEDS
SANILAC CO., MICHIGAN

Register of Deeds Stamp & File Number

	A	B	C	D	E	F	G	H	I	J	K	L	M
1													
2	6		5		4		3		2		1		
3													
4	7		8		9		10		11		12		
5													
6	18		17		16		15		14		13		
7													
8	19		20		21		22		23		24		
9													
10	30		29		28		27		26		25		
11													
12	31		32		33		34		35		36		
13													

APPROVED PEER BOARD MEETING
NOV 30, 1998

SURVEY &
REMONUMENTATION

JAN 15 1999

SECTION

Signed by John A. MilletticsDate Nov 19, 98Surveyor's Michigan License No. 25859