

ST. CLAIR COUNTY, MICHIGAN  
OFFICIAL GOVERNMENT CORNER



LAND CORNER RECORDATION CERTIFICATE  
Filing Requirement of Act 74, Mich. P.A. 1970

	Located In:	Corner Code #
	Berlin Twp.	
	6N 13E	I-1
1. Public Land Survey	T ___ R ___	
	T ___ R ___	
	T ___ R ___	
	T ___ R ___	
2. Property Controlling in Section	S ___ T ___ R ___	
	S ___ T ___ R ___	
3. Miscellaneous	S ___ T ___ R ___	
Property in Sec.	S ___ T ___ R ___	

RECEIVED  
1895 AUG - 4 11:10:1  
REGISTER OF DEEDS  
ST. CLAIR COUNTY  
Register of Deeds Stamp & File Number

4. Lot No. \_\_\_\_\_, Recorded Plat \_\_\_\_\_  
5. Private Claims \_\_\_\_\_

Daniel E. Johnson February 7, 95

I, \_\_\_\_\_, in a field survey on \_\_\_\_\_, 19\_\_\_\_\_, do hereby certify that under requirements of P.A. 74, Michigan P.A. of 1970, the corner points mentioned in lines 1 and 2 above were in conformance with regulations and rules therefore as required in the current manual of survey instructions of the United States Department of the Interior, Bureau of Land Management or by a decree of a Court of Law and/or that the corner points mentioned in lines 3, 4 and 5 above were in conformance with the rules of the Michigan Board of Land Surveyors or by a Decree of a Court of Law; established, re-established, monumented, re-monumented, recovered, found as expressed below:

NOTE: Not more than 1 corner, may be recorded on this certificate.

A. Description of original monument and accessories and/or subsequent restoration:

LIBER 007 PAGE 261

STATE PLAIN COORDINATES


N. \_\_\_\_\_

E. \_\_\_\_\_

ELEVATION \_\_\_\_\_

B. Description of corner evidence found and/or method applied in restoring or reestablishing corner:

LIBER 007 PAGE 261

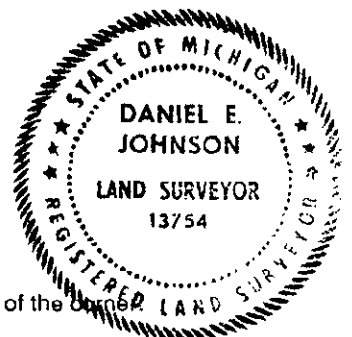

C. Description of monument for corner and accessories established to perpetuate locating the position of the corner:  
Set 2" dia. aluminum cap inscribed "St. Clair County Official Corner" with magnet  
on a  
3/4" Iron Bar. (1.11' North of line between sec. corners, SW35, S435, T. 7N. R. 13E.)  
Set short 1/2 R Bar With Cap #24615 above.

44.21' NE to set P.K. and County Tag in Underground Tele Support Post.  
Above spike in MDSH Tag.

127.31' NW to set P.K. and County Tag in P.Pole.  
253.28' SW to set P.K. and County Tag in P.Pole.  
202.65' NE to set P.K. and County Tag in P.Pole.

Signed by Daniel E. Johnson Daniel E. Johnson  
Surveyor's Michigan License No. 13754

Date February 7, 1995

PA 345-1990  
PEER COMMITTEE

APPROVED 6-17-94 Daniel E. Johnson

APPROVED AS AN OFFICIAL GOVERNMENT CORNER BY ST. CLAIR COUNTY:

Signed By: Daniel E. Johnson Daniel E. Johnson  
St. Clair County Land Surveyor  
13754

Date JULY 25, 1995  
Date  
1182 008 71