

ST. CLAIR COUNTY, MICHIGAN
OFFICIAL GOVERNMENT CORNER



LAND CORNER RECORDATION CERTIFICATE
Filing Requirement of Act 74, Mich. P.A. 1970

	Located In:	Corner Code --#
	Berlin Twp.	
	6N 13E	C-1
1. Public Land Survey	T ___ R ___	
	T ___ R ___	
	T ___ R ___	
	T ___ R ___	
2. Property Controlling in Section	S ___ T ___ R ___	Seg. #2
	S ___ T ___ R ___	
3. Miscellaneous Property in Sec.	S ___ T ___ R ___	
	S ___ T ___ R ___	

1995 ACS-4 (M 10: 16)
REGISTERED
ST. CLAIR COUNTY
Register of Deeds Stamp & File Number

4. Lot No. _____, Recorded Plat _____
5. Private Claims _____

Daniel E. Johnson

February 8, 1995

I, _____, in a field survey on _____, 1995, do hereby certify that under requirements of P.A. 74, Michigan P.A. of 1970, the corner points mentioned in lines 1 and 2 above were in conformance with regulations and rules therefore as required in the current manual of survey instructions of the United States Department of the Interior, Bureau of Land Management or by a decree of a Court of Law and/or that the corner points mentioned in lines 3, 4 and 5 above were in conformance with the rules of the Michigan Board of Land Surveyors or by a Decree of a Court of Law; established, re-established, monumented, re-monumented, recovered, found as expressed below:

NOTE: Not more than 1 corner, may be recorded on this certificate.

A. Description of original monument and accessories and/or subsequent restoration:

LIBER 007 PAGE 273

STATE PLAIN COORDINATES


N. _____

E. _____

B. Description of corner evidence found and/or method applied in restoring or reestablishing corner:

LIBER 007 PAGE 273

ELEVATION _____

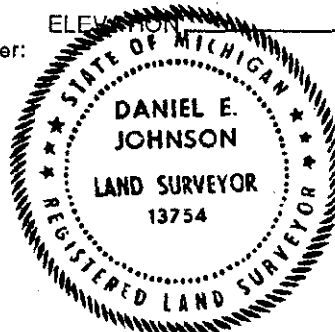

C. Description of monument for corner and accessories established to perpetuate locating the position of the corner:

Set 1/2" x 18" Rerod with 2" dia. aluminum cap inscribed "St. Clair County Official Corner" with magnet

above a

3/4" pipe. (15.2' South of line between section corners, SW 32, S $\frac{1}{2}$ 32, T. 7N., R13, E.)

129.00' ESE to set P.K. and County Tag in 24" Cottonwood.

61.81' NNW to set P.K. and County Tag in P. Pole.

31.97' SSW to set P.K. and County Tag in 24" Maple.

71.01' SW to set P.K. and County Tag in P. Pole.

3.0± North to corner of Burt Road.

9.0± East to remains of occupation line to South.

Signed by _____

Date February 8, 1995

Daniel E. Johnson
13754

Surveyor's Michigan License No. _____

APPROVED AS AN OFFICIAL GOVERNMENT CORNER BY ST. CLAIR COUNTY:

Signed By: _____

St. Clair County Land Surveyor

Daniel E. Johnson
13754

PA 345-1990

PEER COMMITTEE

APPROVED 6-17-94

7-25-95 Date

LIBER 008 PAGE 77