

ST. CLAIR COUNTY, MICHIGAN
OFFICIAL GOVERNMENT CORNER



LAND CORNER RECORDATION CERTIFICATE
Filing Requirement of Act 74, Mich. P.A. 1970

Located In: Corner Code #

1. Public Land Survey T 8N R 14E D-1
T R
T R
T R

2. Property Controlling S T R
in Section S T R
3. Miscellaneous S T R
Property in Sec. S T R

Seg. #2

Register of Deeds Stamp & File Number

4. Lot No. , Recorded Plat
5. Private Claims

Daniel E. Johnson

I, in a field survey on May 23, 19 95, do hereby certify that under requirements of P.A. 74, Michigan P.A. of 1970, the corner points mentioned in lines 1 and 2 above were in conformance with regulations and rules therefore as required in the current manual of survey instructions of the United States Department of the Interior, Bureau of Land Management or by a decree of a Court of Law and/or that the corner points mentioned in lines 3, 4 and 5 above were in conformance with the rules of the Michigan Board of Land Surveyors or by a Decree of a Court of Law; established, re-established, monumented, re-monumented, recovered, found as expressed below:

NOTE: Not more than 1 corner, may be recorded on this certificate.

A. Description of original monument and accessories and/or subsequent restoration:

LIBER 007 PAGE 295

STATE PLAIN COORDINATES


N. _____

E. _____

ELEVATION _____

B. Description of corner evidence found and/or method applied in restoring or reestablishing corner:

LIBER 007 PAGE 295

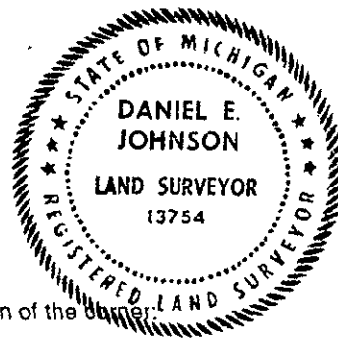

C. Description of monument for corner and accessories established to perpetuate locating the position of the corner:

Set 2" Dia. Aluminum Cap inscribed "St Clair County Official Corner" with magnet on a
1/2" Rebar. (1.93' North of linen between section corners, S 1/4 32, SE 32, T.7N., R.14E.)
72.58' NE to set P.K. and County Tag in 30" Oak.
88.64' SSE to set P.K. and County Tag in Utility Pole (1979).
98.83' NW to set P.K. and County Tag in 38" Oak.
80.47' ESE to set P.K. and County Tag in 4" x 6" Post.
3.04' South to Axle Shaft (county road P.I.)

Signed by Daniel E. Johnson

Date May 23, 1995

Surveyor's Michigan License No. 13754

PA 345-1990

RECORDS COMMITTEE

APPROVED 6-24-94

APPROVED AS AN OFFICIAL GOVERNMENT CORNER BY ST. CLAIR COUNTY:

Signed By: Daniel E. Johnson
St. Clair County Land Surveyor Daniel E. Johnson

Date

Surveyor's Michigan License No. 13754

LIBER 008 PAGE 181