

ST. CLAIR COUNTY, MICHIGAN
OFFICIAL GOVERNMENT CORNER



LAND CORNER RECORDATION CERTIFICATE
Filing Requirement of Act 74, Mich. P.A. 1970

Located In: Corner Code #

1. Public Land Survey T 6N R 14E E-1
T R
T R
T R
2. Property Controlling S T R
in Section S T R
3. Miscellaneous S T R
Property in Sec. S T R

Register of Deeds Stamp & File Number

4. Lot No. , Recorded Plat
5. Private Claims

Daniel E. Johnson
I, in a field survey on April 26, 1994, do hereby certify that under requirements of P.A. 74, Michigan P.A. of 1970, the corner points mentioned in lines 1 and 2 above were in conformance with regulations and rules therefore as required in the current manual of survey instructions of the United States Department of the Interior, Bureau of Land Management or by a decree of a Court of Law and/or that the corner points mentioned in lines 3, 4 and 5 above were in conformance with the rules of the Michigan Board of Land Surveyors or by a Decree of a Court of Law, established, re-established, monumented, re-monumented, recovered, found as expressed below:

NOTE: Not more than 1 corner, may be recorded on this certificate.

- A. Description of original monument and accessories and/or subsequent restoration:

LIBER 007 PAGE 293

STATE PLAIN COORDINATES


N. _____

E. _____

ELEVATION _____

- B. Description of corner evidence found and/or method applied in restoring or reestablishing corner:

LIBER 007 PAGE 293

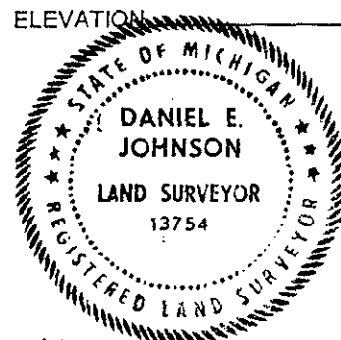

- C. Description of monument for corner and accessories established to perpetuate locating the position of the corner.

"ACCEPTED MICHIGAN DEPARTMENT OF TRANSPORTATION BRASS DISC"
MDOT 5/8" Rod with brass disk (1.75' North to line between section corners
SW 33, S $\frac{1}{4}$ 33, T.7N., R.14E.)

68.42' SW to set P.K. and County Tag in P. Pole.
52.86' SE to set P.K. and County Tag in Underground Tele Riser Post.
129.13' WNW to set P.K. and County Tag in Corner FE Post.
48.98' SW to set P.K. and County Tag in Underground Tele Riser Post.
1.80' S to Axle Shaft & Corner Rec'd in L.6, P.243A.

Signed by Daniel E. Johnson
Daniel E. Johnson
Surveyor's Michigan License No. 13754

Date April 26, 1994

PA 345-1990
PEER COMMITTEE

APPROVED 6-17-94

APPROVED AS AN OFFICIAL GOVERNMENT CORNER BY ST. CLAIR COUNTY:

Signed By: Daniel E. Johnson
St. Clair County Land Surveyor Daniel E. Johnson
13754

7/25/95
Date

Surveyor's Michigan License No. _____

LIBER 008 PAGE 180