

ST. CLAIR COUNTY, MICHIGAN
OFFICIAL GOVERNMENT CORNER

LAND CORNER RECORDATION CERTIFICATE
Filing Requirement of Act 74, Mich. P.A. 1970



RECEIVED
ST. CLAIR COUNTY
REC'D - 4 M 10: 26

Located In: Corner Code #

1. Public Land Survey
2. Property Controlling in Section
3. Miscellaneous Property in Sec.
Wales Twp.
T6N. R15E. M-1
T R
T R
T R
S T R
S T R
S T R
S T R

Register of Deeds Stamp & File Number

4. Lot No. Recorded Plat
5. Private Claims

Daniel E. Johnson April 17, 95

I, in a field survey on 19 do hereby certify that under requirements of P.A. 74, Michigan P.A. of 1970, the corner points mentioned in lines 1 and 2 above were in conformance with regulations and rules therefore as required in the current manual of survey instructions of the United States Department of the Interior, Bureau of Land Management or by a decree of a Court of Law and/or that the corner points mentioned in lines 3, 4 and 5 above were in conformance with the rules of the Michigan Board of Land Surveyors or by a Decree of a Court of Law, established, re-established, monumented, re-monumented, recovered, found as expressed below:

NOTE: Not more than 1 corner, may be recorded on this certificate.

A. Description of original monument and accessories and/or subsequent restoration:

LIBER 007 PAGE 138


STATE PLAIN COORDINATES

N. _____

E. _____

B. Description of corner evidence found and/or method applied in restoring or reestablishing corner:

LIBER 007 PAGE 138

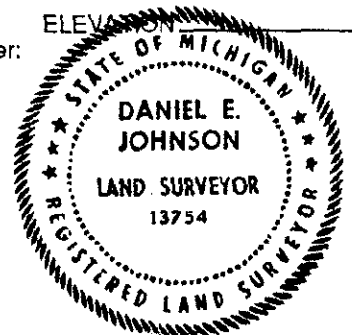

C. Description of monument for corner and accessories established to perpetuate locating the position of the corner:

Set 2" dia. aluminum cap inscribed "St Clair County Official Corner" with magnet (in Monument Box) on an Axle in Monument Box.

S. 49.97' to P.K. and County Tag in W. face of D.E.P.
NNE 54.72' to P.K. and County Tag in SW face of D.E.P.
NW 92.80' to P.K. and County Tag in SW face of Telephone Pole
W. 1843.60' to SW Corner Section 31 T7N, R16E.

(Corner is on centerline of existing Lapeer Road pavement)

This corner common to NW corner Sectin 6 T6N, R16E (A-1)

Signed by Daniel E. Johnson
13754

Date April 17, 1995

Surveyor's Michigan License No.

PA 345-1990
PEER COMMITTEE

APPROVED AS AN OFFICIAL GOVERNMENT CORNER BY ST. CLAIR COUNTY:

Signed By: Daniel E. Johnson
St. Clair County Land Surveyor
13754

APPROVED 12-7-93

7-31-95

Surveyor's Michigan License No.

Date
LIBER 008 PAGE 199