

RECEIVED
ST. CLAIR COUNTY

12:21 SEP 20 PM 2:22

REGISTER OF DEEDS
ST. CLAIR COUNTY

ST. CLAIR COUNTY, MICHIGAN
OFFICIAL GOVERNMENT CORNER



LAND CORNER RECORDATION CERTIFICATE
Filing Requirement of Act 74, Mich. P.A. 1970

Located In: Corner Code ~~##~~

1. Public Land Survey T 7N R 14E C-13
T _____ R _____
T _____ R _____
T _____ R _____
2. Property Controlling S _____ T _____ R _____
in Section S _____ T _____ R _____
3. Miscellaneous S _____ T _____ R _____
Property in Sec. S _____ T _____ R _____

Register of Deeds Stamp & File Number

4. Lot No. _____, Recorded Plat _____
5. Private Claims _____

Michael J. Rossow

April 29, 94

I, _____, in a field survey on _____, 19 _____, do hereby certify that under requirements of P.A. 74, Michigan P.A. of 1970, the corner points mentioned in lines 1 and 2 above were in conformance with regulations and rules therefore as required in the current manual of survey instructions of the United States Department of the Interior, Bureau of Land Management or by a decree of a Court of Law and/or that the corner points mentioned in lines 3, 4 and 5 above were in conformance with the rules of the Michigan Board of Land Surveyors or by a Decree of a Court of Law; established, re-established, monumented, re-monumented, recovered, found as expressed below:

NOTE: Not more than 1 corner, may be recorded on this certificate.

A. Description of original monument and accessories and/or subsequent restoration:

"Post" set (Government Survey).

St. Clair County Surveyors Record Lists ("Large Stone").

Act 74 Cert. L.4, P.113 Identifies a 1/2" Rerod.

B. Description of corner evidence found and/or method applied in restoring or reestablishing corner:

Found Monument box with 5/8" Rebar. Per witnesses of
St. Clair Co. Road Comm. on 07-03-84.

C. Description of monument for corner and accessories established to perpetuate locating the position of the corner:

5/8" Rebar.

113.51' NW to P.K. and County Tag in P.Pole-1981 above F. P.K.
108.32' NE to P.K. and County Tag in P.Pole
125.40' SE to P.K. and County Tag in Willow
95.20' SW to P.K. and County Tag in P.Pole-below F. P.K.

SEE ATTACHED SKETCH FOR ADDITIONAL INFORMATION.

Signed by _____
Michael J. Rossow
Surveyor's Michigan License No. 24615

Date May 12, 1994
PA 345-1990
PEER COM
APPROVED 5-20-94



APPROVED AS AN OFFICIAL GOVERNMENT CORNER BY ST. CLAIR COUNTY:

Signed By: _____
St. Clair County Land Surveyor

Surveyor's Michigan License No. _____

Date
LIBER 007 PAGE 345




	A	B	C	D	E	F	G	H	I	J	K	L	M
2	6	5	4	3	2	1							
3													
4	7	8	9	10	11	12							
5													
6	18	17	16	15	14	13							
7													
8	19	20	21	22	23	24							
9													
10	30	29	28	27	26	25							
11													
12	31	32	33	34	35	36							
13													

STATE PLAIN COORDINATES

N. _____

E. _____

ELEVATION _____

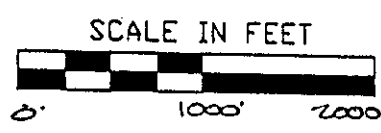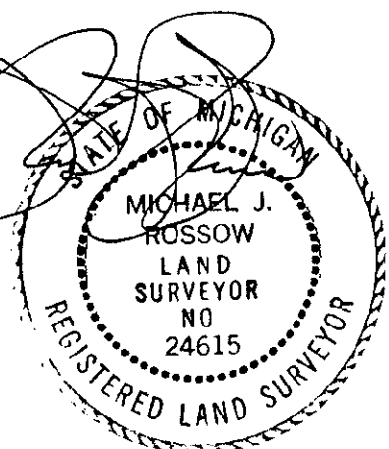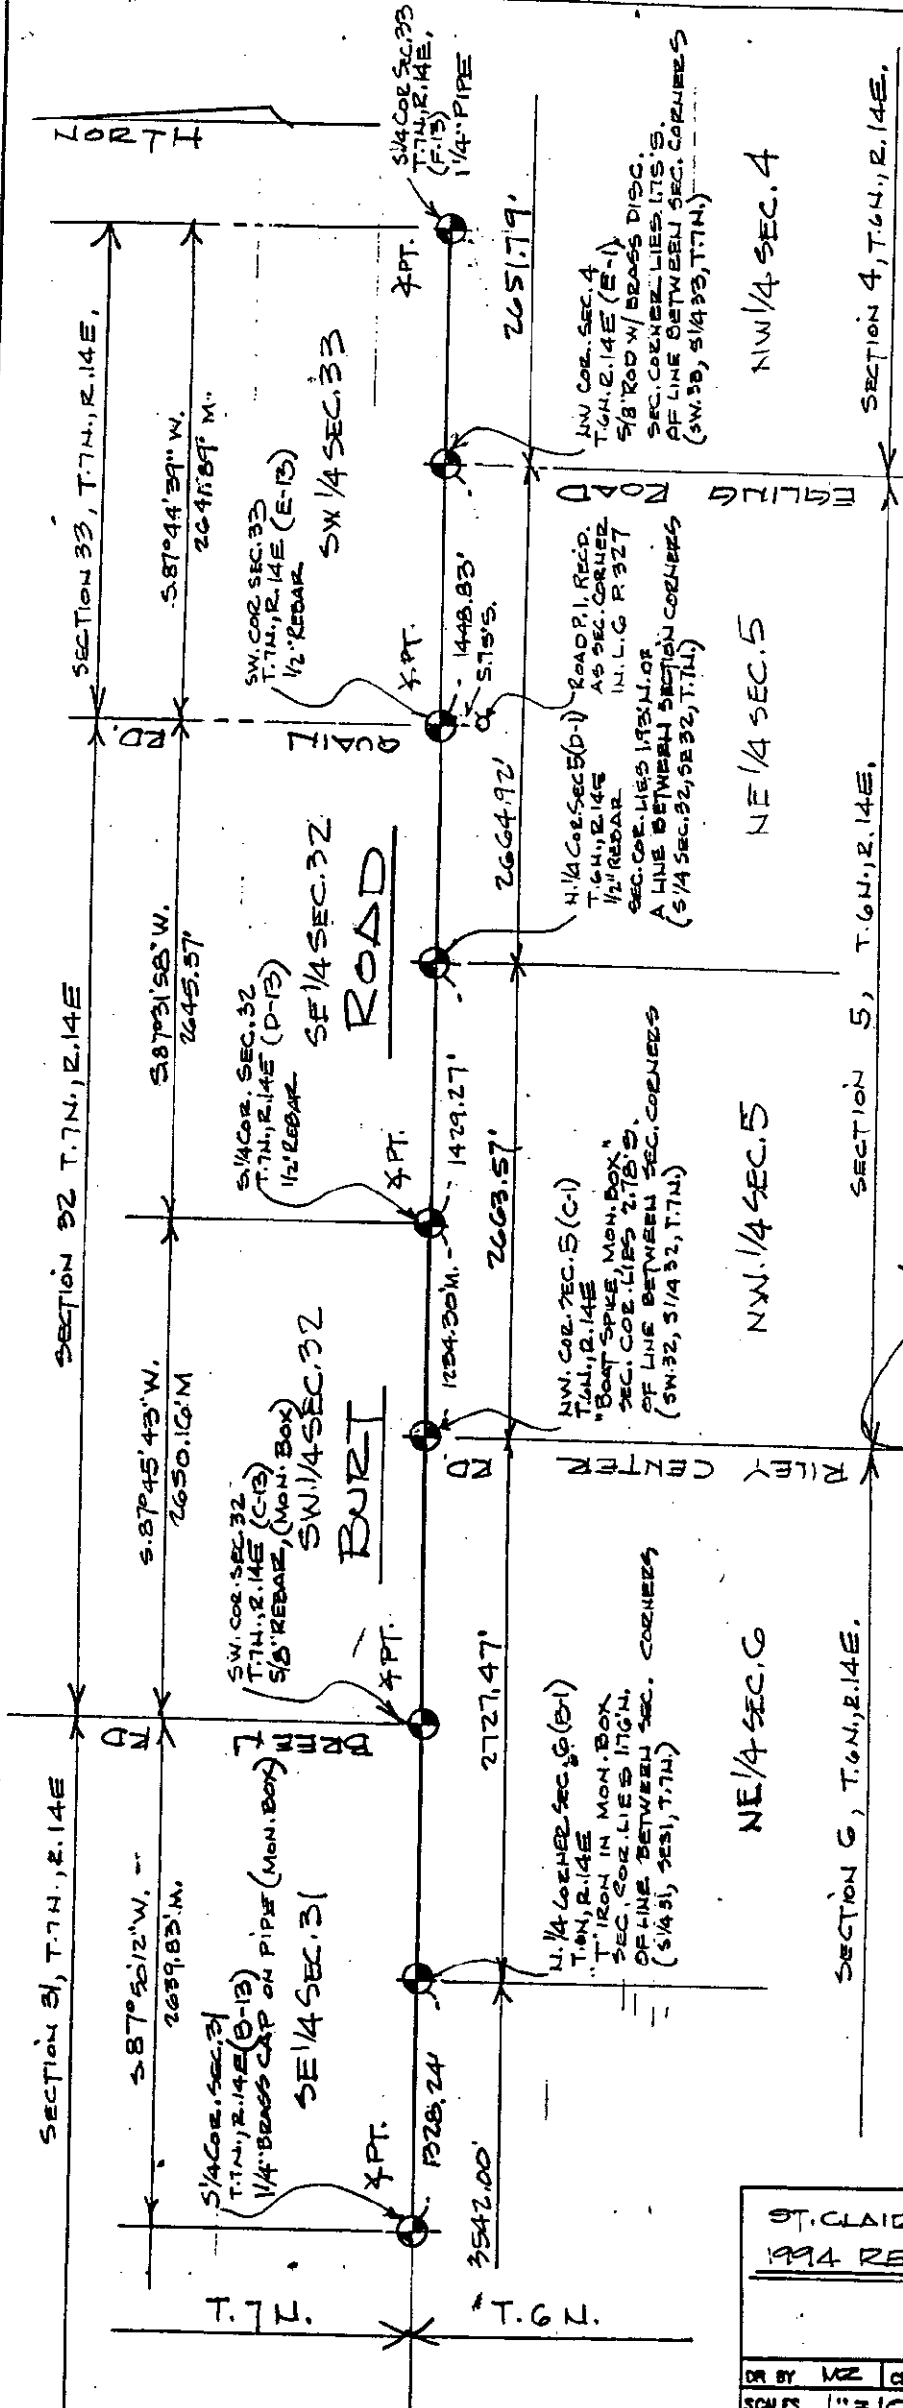

LEGEND

O	SET IRON
●	FOUND IRON
R	RECORDED
M	MEASURED
C	CALCULATED
-x-x-	FENCE
-x-x-	GOVT. CORNER

NOTE: ALL DISTANCES & ANGLES
MEASURED ELECTRONICALLY

ST. CLAIR COUNTY, MICHIGAN
1994 REMONUMENTATION PROGRAM

DR BY MZ	CK BY MZ	SHEET NO. 4	OF	SHEETS
SCALE 1" = 1000'		DATE 4-26-94		
		T.R. VALENTINE & ASSOCIATES INC. Consulting Engineers, Architects & Land Surveyors 901 Huron Ave., Suite 8 Port Huron Michigan 48060 (313) 985-4848		
DWG NO.	JOB NO.			