

ST. CLAIR COUNTY, MICHIGAN
OFFICIAL GOVERNMENT CORNER



LAND CORNER RECORDATION CERTIFICATE
Filing Requirement of Act 74, Mich. P.A. 1970

Located In: Corner Code ~~##~~

1. Public Land Survey T ~~7N~~ R ~~14E~~ ~~E-13~~
T R
T R
T R
2. Property Controlling S T R
in Section S T R
3. Miscellaneous S T R
Property in Sec. S T R

4. Lot No. , Recorded Plat
5. Private Claims

I, Daniel E. Johnson, in a field survey on May 22, 19 95, do hereby certify that under requirements of P.A. 74, Michigan P.A. of 1970, the corner points mentioned in lines 1 and 2 above were in conformance with regulations and rules therefore as required in the current manual of survey instructions of the United States Department of the Interior, Bureau of Land Management or by a decree of a Court of Law and/or that the corner points mentioned in lines 3, 4 and 5 above were in conformance with the rules of the Michigan Board of Land Surveyors or by a Decree of a Court of Law; established, re-established, monumented, re-monumented, recovered, found as expressed below:

NOTE: Not more than 1 corner, may be recorded on this certificate.

A. Description of original monument and accessories and/or subsequent restoration:

LIBER 007 PAGE 341

B. Description of corner evidence found and/or method applied in restoring or reestablishing corner:

LIBER 007 PAGE 341

C. Description of monument for corner and accessories established to perpetuate locating the position of the corner:

Set 2" Dia. Aluminum Cap inscribed "St. Clair County Official Corner" with magnet over 1/2" Rebar.

52.18' SW to set P.K. and County Tag in 24" Maple.
148.03' NNE to set P.K. and County Tag in 15" Hickory.
180.15' NNW to set P.K. and County Tag in 27" Oak
138.30' SE to set P.K. and County Tag in P.Pole

Signed by Daniel E. Johnson
Daniel E. Johnson
Surveyor's Michigan License No. 13754

Date May 22, 1995

APPROVED AS AN OFFICIAL GOVERNMENT CORNER BY ST. CLAIR COUNTY:

Signed By: Daniel E. Johnson
Daniel E. Johnson
St. Clair County Land Surveyor

Surveyor's Michigan License No. 13754

1995 JUN - 4 AM 10:14
REGISTERED OF RECORD
ST. CLAIR COUNTY
RECEIVED
Register of Deeds Stamp & File Number


	A	B	C	D	E	F	G	H	I	J	K	L	M
2	6	5	4	3	2	1							
3													
4	7	8	9	10	11	12							
5													
6	18	17	16	15	14	13							
7													
8	19	20	21	22	23	24							
9													
10	30	29	28	27	26	25							
11													
12	31	32	33	34	35	36							
13													

STATE PLAIN COORDINATES

N. _____

E. _____

ELEVATION _____

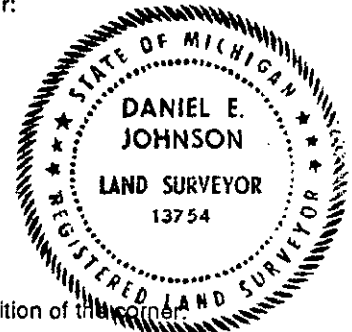

PA 345-1990

PEER COMMITTEE

APPROVED 5-20-94 Dub

7-31-95

LIBER 008 PAGE 98