

ST. CLAIR COUNTY, MICHIGAN
OFFICIAL GOVERNMENT CORNER



LAND CORNER RECORDATION CERTIFICATE
Filing Requirement of Act 74, Mich. P.A. 1970

Located In: Corner Code #

1. Public Land Survey T 7N R 15E G-13
T R
T R
T R
2. Property Controlling S T R
in Section S T R
3. Miscellaneous S T R
Property in Sec. S T R

4. Lot No. , Recorded Plat
5. Private Claims

RECEIVED
1993 DEC 29 AM 10:04
Register of Deeds Stamp & File Number

I, David J. Little, in a field survey on October 4, 1993,
do hereby certify that under requirements of P.A. 74, Michigan P.A. of 1970, the corner points mentioned
in lines 1 and 2 above were in conformance with regulations and rules therefore as required in the
current manual of survey instructions of the United States Department of the Interior, Bureau of Land
Management or by a decree of a Court of Law and/or that the corner points mentioned in lines 3, 4 and 5
above were in conformance with the rules of the Michigan Board of Land Surveyors or by a Decree of a
Court of Law; established, re-established, monumented, re-monumented, recovered, found as
expressed below:

NOTE: Not more than 1 corner, may be recorded on this certificate.

A. Description of original monument and accessories and/or subsequent restoration:

Post-(Government Surveys)

1" Iron Pipe listed on Old Suveyor's Record St. Clair
County.

Recordation Certificates L.1 P.376 and L.4 P.140
agrees with this corner.

B. Description of corner evidence found and/or method applied in restoring or reestablishing corner:

Found 1" Iron Pipe

2159A000 12/29/93HSSU4 9.00
0001


2159A000 12/29/93SSRE4 2.00
0001

C. Description of monument for corner and accessories established to perpetuate locating the position of the corner:

Found 1" Iron Pipe

S.E. 52.08' to P.K. and County Tag in W. face of D.E.P.
S.S.E. 126.40' to P.K. and County Tag in W. face of 36' Oak.
N.E. 73.70' to P.K. and County Tag in N.W. face of 12" Ash
W. 41.62' to P.K. and County Tag in S. face of 10" Ash.

See attached sketch for additional information.

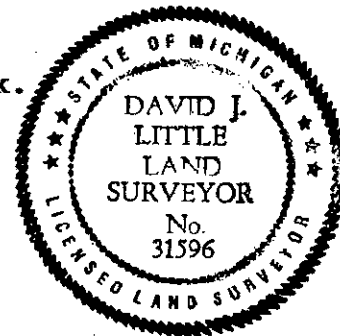

Signed by David J. Little
Surveyor's Michigan License No. 31596

Date

November 20, 1993
PA 345-1990
PEER COMMITTEE

APPROVED 12-7-93

APPROVED AS AN OFFICIAL GOVERNMENT CORNER BY ST. CLAIR COUNTY:

Signed By: _____
St. Clair County Land Surveyor

Surveyor's Michigan License No. _____

LIBER 007 PAGE 161

