

ST. CLAIR COUNTY, MICHIGAN
OFFICIAL GOVERNMENT CORNER



LAND CORNER RECORDATION CERTIFICATE
Filing Requirement of Act 74, Mich. P.A. 1970

Located In: Corner Code ##

1. Public Land Survey T 7N R 15E H-13
T _____ R _____
T _____ R _____
T _____ R _____
2. Property Controlling S _____ T _____ R _____
in Section S _____ T _____ R _____
3. Miscellaneous S _____ T _____ R _____
Property in Sec. S _____ T _____ R _____

4. Lot No. _____, Recorded Plat _____
5. Private Claims _____

RECEIVED
1993 DEC 29 AM 9:03
REGISTER OF DEEDS ST. CLAIR COUNTY
Register of Deeds Stamp & File Number

I, David J. Little, in a field survey on October 4, 1993, do hereby certify that under requirements of P.A. 74, Michigan P.A. of 1970, the corner points mentioned in lines 1 and 2 above were in conformance with regulations and rules therefore as required in the current manual of survey instructions of the United States Department of the Interior, Bureau of Land Management or by a decree of a Court of Law and/or that the corner points mentioned in lines 3, 4 and 5 above were in conformance with the rules of the Michigan Board of Land Surveyors or by a Decree of a Court of Law; established, re-established, monumented, re-monumented, recovered, found as expressed below:

NOTE: Not more than 1 corner, may be recorded on this certificate.

A. Description of original monument and accessories and/or subsequent restoration:

Post-(Government Surveys)

Nothing Listed on Old Surveyor's Record St. Clair County for this corner.

No Certificate filed on this corner.

B. Description of corner evidence found and/or method applied in restoring or reestablishing corner:

Found 3/4" Iron Pipe in Monument Box.

3/4" Iron Pipe agrees with 1952 Michigan State Highway Department Road Plans

Found R.R. Spike 8.4'E and 5.2'N

Found Iron Rod 2'N and 2'E

2159A000 12/29/93MSSU4 9.00
0001

2159A000 12/29/93SSRE4 2.00
0001

C. Description of monument for corner and accessories established to perpetuate locating the position of the corner:

Found 3/4" Iron Pipe in Monument Box.

N.E. 151.53' to P.K. and County Tag in utility pole.

S.W. 26.92' to N.E. corner of conc. headwall.

S.E. 36.50' to N.W. corner of conc. headwall.

N. 132.05' to P.K. and County Tag in S.E. face of 12" Maple.

See attached sketch for additional information.



Signed by David J. Little

Date November 20, 1993

Surveyor's Michigan License No. 31596

PA 345-1990

PEER COMMITTEE

APPROVED 12-14-93

APPROVED AS AN OFFICIAL GOVERNMENT CORNER BY ST. CLAIR COUNTY:

Signed By: _____

St. Clair County Land Surveyor


Date

Surveyor's Michigan License No. _____

LIBER 007 PAGE 157

Certificate of Survey

N

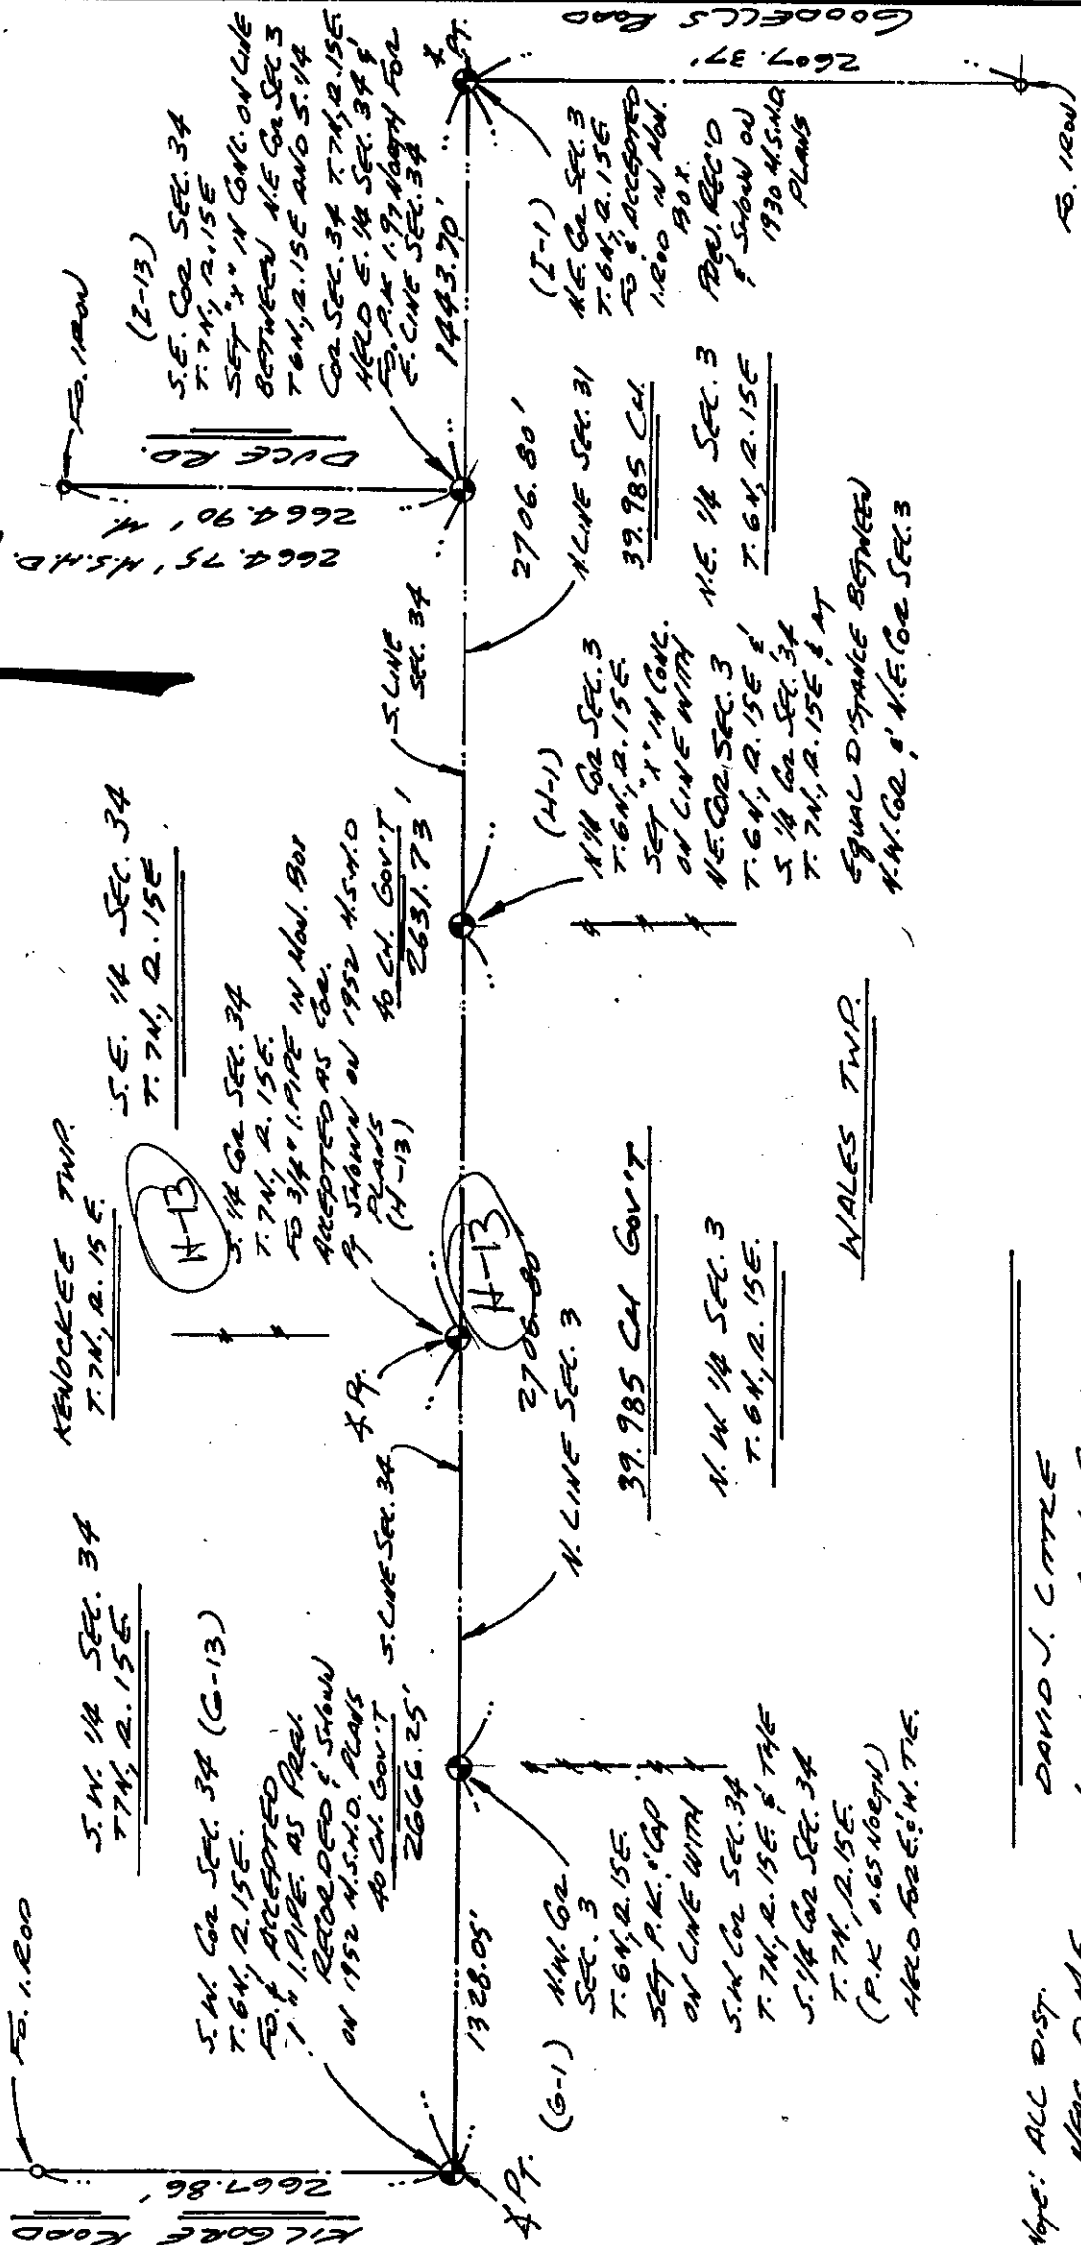

Notes: ALL DIST.
MEAS. O.M.E.
DAVID J. LITTLE
LICENSED LAND SURVEYOR
NOVEMBER 20, 1993



DAVID J. LITTLE

2833 GRATIOT BOULEVARD, MARYSVILLE, MICHIGAN 48040
LICENSED LAND SURVEYORS

0.7	
13600	
11.20.93	93-147