

ST. CLAIR COUNTY, MICHIGAN
OFFICIAL GOVERNMENT CORNER



LAND CORNER RECORDATION CERTIFICATE
Filing Requirement of Act 74, Mich. P.A. 1970

Located In: Corner Code #

Kenockee Twp.

1. Public Land Survey T 7N. R 15E. M-13
T _____ R _____
T _____ R _____
T _____ R _____
T _____ R _____
2. Property Controlling S _____ T _____ R _____
in Section S _____ T _____ R _____
3. Miscellaneous S _____ T _____ R _____
Property in Sec. S _____ T _____ R _____

4. Lot No. _____, Recorded Plat _____
5. Private Claims _____

RECEIVED
1995 AUG -4 AM 10:18
REGISTER OF DEEDS
ST. CLAIR COUNTY
Register of Deeds Stamp & File Number

I, Daniel E. Johnson, in a field survey on May 26, 1995,
do hereby certify that under requirements of P.A. 74, Michigan P.A. of 1970, the corner points mentioned
in lines 1 and 2 above were in conformance with regulations and rules therefore as required in the
current manual of survey instructions of the United States Department of the Interior, Bureau of Land
Management or by a decree of a Court of Law and/or that the corner points mentioned in lines 3, 4 and 5
above were in conformance with the rules of the Michigan Board of Land Surveyors or by a Decree of a
Court of Law, established, re-established, monumented, re-monumented, recovered, found as
expressed below:

NOTE: Not more than 1 corner, may be recorded on this certificate.

A. Description of original monument and accessories and/or subsequent restoration:

LIBER 007 PAGE 136

STATE PLAIN COORDINATES


N. _____

E. _____

B. Description of corner evidence found and/or method applied in restoring or reestablishing corner:

LIBER 007 PAGE 136

ELEVATION _____

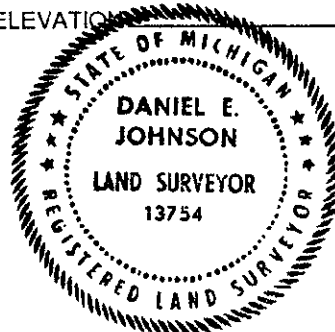

C. Description of monument for corner and accessories established to perpetuate locating the position of the corner:

Set 1/2 x 42" Rerod with 2" dia. aluminum cap inscribed "St. Clair County Official
Corner" with magnet (In Monument Box)

on a

1" Iron in Monument Box.

NW 76.85' to set PK and County Tag in D.E.P.
SE 83.90' to set PK and County Tag in 36" Oak
SW 76.45' to set PK and County Tag in D.E.P.
NE 120.70' to set PK and County Tag in D.E.P.

(Corner is on centerline of existing Lapeer Rd. pavement)

Corner common to SW Corner Section 31 T7N, R16E

Signed by Daniel E. Johnson Date May 26, 1995

Surveyor's Michigan License No. 13754

PA 345-1990
PEER COMMITTEE

APPROVED 12-7-93

APPROVED AS AN OFFICIAL GOVERNMENT CORNER BY ST. CLAIR COUNTY:

Signed By: Daniel E. Johnson

St. Clair County Land Surveyor Daniel E. Johnson

Surveyor's Michigan License No. 13754

Date

7-31-95
LIBER 008 PAGE 119