

ST. CLAIR COUNTY, MICHIGAN
OFFICIAL GOVERNMENT CORNER



LAND CORNER RECORDATION CERTIFICATE
Filing Requirement of Act 74, Mich. P.A. 1970

Located In: Corner Code #

1. Public Land Survey T 7N. R 15E. K-13
T _____ R _____
T _____ R _____
T _____ R _____
2. Property Controlling S _____ T _____ R _____
in Section S _____ T _____ R _____
3. Miscellaneous S _____ T _____ R _____
Property in Sec. S _____ T _____ R _____

4. Lot No. _____, Recorded Plat _____
5. Private Claims _____

Daniel E. Johnson May 26, 1995
I, _____, in a field survey on _____, 19____,
do hereby certify that under requirements of P.A. 74, Michigan P.A. of 1970, the corner points mentioned
in lines 1 and 2 above were in conformance with regulations and rules therefore as required in the
current manual of survey instructions of the United States Department of the Interior, Bureau of Land
Management or by a decree of a Court of Law and/or that the corner points mentioned in lines 3, 4 and 5
above were in conformance with the rules of the Michigan Board of Land Surveyors or by a Decree of a
Court of Law; established, re-established, monumented, re-monumented, recovered, found as
expressed below:

NOTE: Not more than 1 corner, may be recorded on this certificate.

- A. Description of original monument and accessories and/or subsequent restoration:

LIBER 007 PAGE 144

STATE PLAIN COORDINATES


N. _____

E. _____

ELEVATION _____

- B. Description of corner evidence found and/or method applied in restoring or reestablishing corner:

LIBER 007 PAGE 144

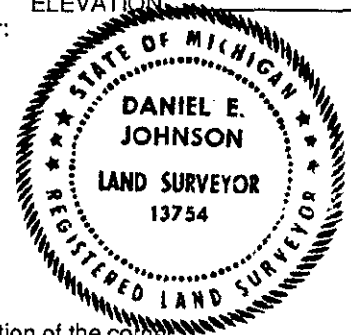

- C. Description of monument for corner and accessories established to perpetuate locating the position of the corner:
Set 1/2"x 42" Rerod with 2" dia. aluminum cap inscribed "St. Clair County Official
Corner" with magnet (In Monument Box)

S 48.82' to set PK and County Tag in E face of D.E.P.
NNE 81.30' to set PK and County Tag in SW face of 48" Maple
SE 147.80' to set PK and County Tag in N face of D.E.P.
NW 73.05' to set PK and County Tag in NE face of Telephone Pole

(corner is on centerline of existing Lapeer Rd. pavement)

Signed by _____ Date May 26, 1995

Surveyor's Michigan License No. Daniel E. Johnson
#13754

PA 345-1990
PEER COMMITTEE

APPROVED 12-7-93

APPROVED AS AN OFFICIAL GOVERNMENT CORNER BY ST. CLAIR COUNTY:

Signed By: _____ Date 7-31-95

St. Clair County Land Surveyor Daniel E. Johnson
#13754

Surveyor's Michigan License No. _____

LIBER 008 PAGE 117