

MAY 07 1997

COMMISSION

LAND CORNER RECORDATION CERTIFICATE
Filing Requirement of Act 74, Mich. P.A. 1970

For corners in
St. Joseph
(County)

Located In:

Corner Code #

LIBER 4 PAGE 287

STATE OF MICHIGAN
ST. JOSEPH COUNTY
FILED

30 DEC 96 1:59 P.M.

CYNTHIA JARRATT
REGISTER OF DEEDS

Register of Deeds Stamp & File Number

1. Public Land Survey T 5S R 10W F-11
T R
T R
T R
2. Property Controlling S T R
in Section S T R
3. Miscellaneous S T R
Property in Sec. S T R
4. Lot No. , Recorded Plat
5. Private Claims

I, Donald C. Andrews, in a field survey on May 2, 1996, do hereby certify that under requirements of P.A. of 1970, the corner points mentioned in lines 1 and 2 above were in conformance with regulations and rules therefore as required in the current manual of survey instructions of the United States Department of the Interior, Bureau of Land Management or by a decree of a Court of Law and/or that the corner points mentioned in lines 3, 4 and 5 above were in conformance with the rules of the Michigan Board of Land Surveyors or a Decree of a Court of Law; established, re-established, monumented, re-monumented, recovered, found as expressed below:

NOTE: Not more than 4 corners, all in the same town and range, may be recorded on this certificate.

A. Description of original monument and accessories and/or subsequent restoration:

F-11
GLO Post

	A	B	C	D	E	F	G	H	I	J	K	L	M
2	6		5		4		3		2		1		
3													
4	7		8		9		10		11		12		
5													
6	18		17		16		15		14		13		
7													
8	19		20		21		22		23		24		
9													
10	30		29		28		27		26		25		
11													
12	31		32		33		34		35		36		
13													

B. Description of corner evidence found and/or method applied in restoring or reestablishing corner:


F-11
Set corner mid way between the corners (G-11) and (E-11).

RATIFIED BY PEER GROUP
IN ACCORDANCE WITH P.A. 345
ON May 13, 1996
Uren CO. REPRESENTATIVE

C. Description of monument for corner and accessories established to perpetuate locating the position of the corner:

F-11
Set Alum. Capped iron 5/8"x24": 1) 24" Cherry S45°W 2.56', 2) 24" Cherry N45°W 3.43', 3) 18" Oak N45°E 31.84', 4) 16" Elm S50°W 35.36'.

Signed by Donald C. Andrews
Donald C. Andrews, P.S.
Surveyor's Michigan License No. 33967

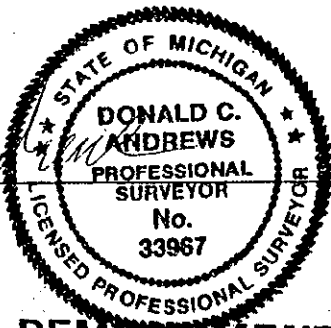

Date 12/23/96