

# LAND CORNER RECORDATION CERTIFICATE

Filing Requirement of Act 74, Mich. P.A. 1970

LIBER 4 PAGE 225

For corners in

ST. JOSEPH

(County)

Located in:

Corner Code #

1. Public Land Survey T 5S R 11W J-3  
T R  
T R  
T R
2. Property Controlling S T R  
in Section S T R
3. Miscellaneous S T R  
Property in Sec. S T R
4. Lot No. \_\_\_\_\_, Recorded Plat \_\_\_\_\_
5. Private Claims \_\_\_\_\_

STATE OF MICHIGAN  
ST. JOSEPH COUNTY  
FILED

18 JUN 96 8:37 A.M.

CYNTHIA JARRATT  
REGISTER OF DEEDS

Register of Deeds Stamp & File Number

I, Donald C. Andrews, in a field survey on MAY 30, 1996, do hereby certify that under requirements of P.A. of 1970, the corner points mentioned in lines 1 and 2 above were in conformance with regulations and rules therefore as required in the current manual of survey instructions of the United States Department of the Interior, Bureau of Land Management or by a decree of a Court of Law and/or that the corner points mentioned in lines 3, 4 and 5 above were in conformance with the rules of the Michigan Board of Land Surveyors or a Decree of a Court of Law; established, re-established, monumented, re-monumented, recovered, found as expressed below:

**NOTE: Not more than 4 corners, all in the same town and range, may be recorded on this certificate.**

A. Description of original monument and accessories and/or subsequent restoration:  
GLO POST  
1875 BK A, P 210 POST & 2 WIT TREES 8" B.O. N71°E 35.31', 11" TAMARACK S21°W 26.57'

## SURVEY & REMONUMENTATION

OCT 03 1996

COMMISSION

	A	B	C	D	E	F	G	H	I	J	K	L	M
2	6	5	4	3	2	1							
3													
4	7	8	9	10	11	12							
5													
6	18	17	16	15	14	13							
7													
8	19	20	21	22	23	24							
9													
10	30	29	28	27	26	25							
11													
12	31	32	33	34	35	36							
13													


B. Description of corner evidence found and/or method applied in restoring or reestablishing corner:

FOUND REMAINS OF BOTH WITNESS TREES. PULL RECORD DISTANCE FOUND PIECE OF BRICK AND 2 OLD STAPLES. RESET CORNER PER RECORD WITNESS WITH 5/8" X 24" IRON. CORNER ACCEPTED BY PEER GROUP.

RATIFIED BY PEER GROUP  
IN ACCORDANCE WITH P.A. 345  
ON MAY 13, 1996  
HARRIS CO. REPRESENTATIVE

C. Description of monument for corner and accessories established to perpetuate locating the position of the corner:

5/8" X 24" IRON WITH STANDARD ALUM. CAP:  
22" OAK N5°E 37.05'  
20" OAK S60°E 45.30'  
20" CHERRY S35°E 26.19'  
24" TWIN CHERRY N85°W 4.13'

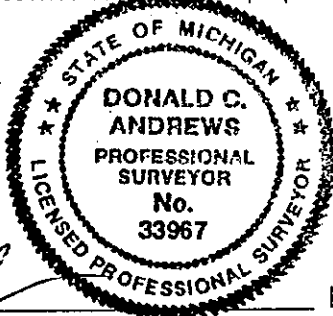

Signed by Donald C. Andrews, P.S.

Date 5/31/96

Surveyor's Michigan License No. 33967

FORM APPROVED BY MICHIGAN STATE BOARD OF LAND SURVEYORS, JAN. 28, 1971  
REVISED MAY 14, 1975  
REVISED JAN., 1983  
ADAPTED FOR WORD-PROCESSING

LIBER 4 PAGE 225

225