

JAN 24 1996

COMMISSION

004 PG 015

LAND CORNER RECORDATION CERTIFICATE

Filing Requirement of Act 74, Mich. P.A. 1970

FILED

DEC 7 10 47 AM '93

Cynthia R. Janetzki  
REGISTER OF DEEDS  
ST. JOSEPH CO. MICH

For corners in

ST. JOSEPH  
(County)

Located In:

Corner Code: ##

FLOWERFIELD TWP.

1. Public Land Survey

T 5S R 12W

D-13

T R

T R

T R

2. Property Controlling  
in Section

S T R

S T R

3. Miscellaneous  
Property in Sec.

S T R

S T R

Register of Deeds Stamp & File Number

4. Lot No. , Recorded Plat

5. Private Claims

I, WAYNE A. MOSTROM in a field survey on 11/8, 1993,  
do hereby certify that under requirements of P.A. 74, Michigan P.A. of 1970, the corner points mentioned  
in lines 1 and 2 above were in conformance with regulations and rules therefore as required in the  
current manual of survey instructions of the United States Department of the Interior, Bureau of Land  
Management or by a decree of a Court of Law and/or that the corner points mentioned in lines 3, 4 and 5  
above were in conformance with the rules of the Michigan Board of Land Surveyors or by a Decree of a  
Court of Law; established, re-established, monumented, re-monumented, recovered, found as  
expressed below:

NOTE: Not more than 4 corners, all in the same town and range, may be recorded  
on this certificate.

A. Description of original monument and accessories and/or subsequent restoration:

GLO

BOOK A, PAGE 650 (1890)

SMITH SURVEY -1973

TREES ARE OUT

BOOK A/PAGE 105 (1865)

STAKE-ORIG. TREES STILL GREEN

15" W.O. = N371/2°E 1.41 CH.

SET STAKE FROM REMAINS OF

ORIG. WITT.-SET NOTCHED STO.

OVER STAKE

10" W.O. = NORTH 48 LKS

12" W.O. = S481/4°E 68 LKS

SET IRON ROD IN MON BOX MIDWAY

BET. SEC. COR'S IN FENCE TO N.

P.P. = S75°E 272' FENCE S. = E 53.5'

SEE LCRC IN L. 1, P. 21

B. Description of corner evidence found and/or method applied in restoring or reestablishing corner:

FOUND 1/2" BAR IN MON BOX IN S E-W RDWY & IN FENCE LINE TO N.

P.P. = S75°E 272'

FENCE TO S. = EAST 53'±

DUG 3' + DEEP - NOTHING FOUND BELOW IRON

C. Description of monument for corner and accessories established to perpetuate locating the position of the corner:

SET 5/8" X 24" IRON BAR & STD. CAP IN MON. BOX


IN FENCE LINE TO N & 52.81'W. OF RR SPIKE MARKING COR. TO SEC. 5

N&W IN 12" LOCUST = NORTH 48.92'

N&W IN 10" ELM = N20°W 44.07'

N&W IN 8" ELM = N50°W 72.21'

APPROVED BY  
PEER GROUP AS  
BEST AVAILABLE  
EVIDENCE OF  
CORNER.

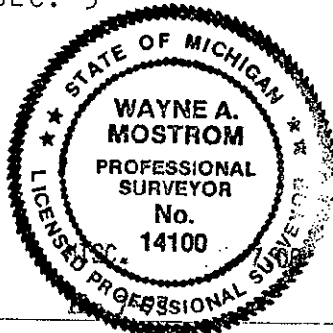

Signed by Wayne A. Mostrom  
Surveyor's Michigan License No. 14100

Date 11/8/93