

# SURVEY & MONUMENTATION

JAN 17 1996

## LAND CORNER RECORDATION CERTIFICATE COMMISSION Filing Requirement of Act 74, Mich. P.A. 1970

LIBER 4 PAGE 136

For corners in  
ST. JOSEPH  
(County)  
COLON TWP.

Located in:

Corner Code #

STATE OF MICHIGAN  
ST. JOSEPH COUNTY  
FILED

11 MAY 95 4:16 P.M.

CYNTHIA JARRATT  
REGISTER OF DEEDS

Register of Deeds Stamp & File Number

1. Public Land Survey T R  
T R  
T R  
T R  
2. Property Controlling S 19 T 6S R 9W A-8  
in Section S T R  
3. Miscellaneous S T R  
Property in Section S T R

4. Lot No. , Recorded Plat  
5. Private Claims

I, DAVID W. MOSTROM, in a field survey on APRIL 7, 1995, do hereby certify that under requirements of P.A. 74, Michigan P.A. of 1970, the corner points mentioned in lines 1 and 2 above were in conformance with regulations and rules therefore as required in the current manual of survey instructions of the United States Department of the Interior, Bureau of Land Management or by a decree of a Court of Law and/or that the corner points mentioned in lines 3, 4 and 5 above were in conformance with the rules of the Michigan Board of Professional Surveyors or by a Decree of a Court of Law; established, re-established, monumented, re-monumented, recovered, found as expressed below:

NOTE: Not more than 4 corners, all in the same town and range, may be recorded on this certificate.

A. Description of original monument and accessories and/or subsequent restoration:

(A-8) WEST 1/4 COR. SEC. 19, COLON TWP.

1865 SURVEY IN BOOK A, PG. 126

STONE SET EQUIDISTANT BETWEEN  
NW & SW SECTION CORNERS  
16" W. OAK = S20°W 38.94'

1875 SURVEY IN BOOK A, PG. 212

STONE SET BY GARDNER  
NO WITNESSES

MDOT RIGHT-OF-WAY MAPS

HWY CENTERLINE =  
EAST 2.61'

A	B	C	D	E	F	G	H	I	J	K	L	M
2	6	5	4	3	2							
3												
4	7	8	9	10	11	12						
5												
6	18	17	16	15	14	13						
7												
8	19	20	21	22	23	24						
9												
10	30	29	28	27	26	25						
11												
12	31	32	33	34	35	36						
13												

B. Description of corner evidence found and/or method applied in restoring or reestablishing corner:

(A-8)


FOUND BOAT SPIKE IN MON. BOX  
CORNER IS 1.18' SOUTH AND 2.81' WEST OF SPLIT BETWEEN SECTION CORNERS  
EXISTING HWY. CENTERLINE = EAST 2.9'±

RATIFIED BY PEER GROUP  
IN ACCORDANCE WITH P.A. 345  
ON MAY 8<sup>th</sup>, 1995  
WAM CO. REPRESENTATIVE

C. Description of monument for corner and accessories established to perpetuate locating the position of the corner:

(A-8)

SET 5/8' X 24" IRON BAR W/STD. CAP IN PLACE OF BOAT SPIKE IN MON. BOX  
EXISTING HWY. CENTERLINE = EAST 2.9'±  
NOTTAWA TWP. COR. = SOUTH 46.07'  
3/4" PIPE = N61°E 49.77'  
3/4" SH. PIPE = S19°E 75.86'  
3/4" SH. PIPE = WEST 23.57'  
CONC. R/W MARKER = S57°E 71.31'

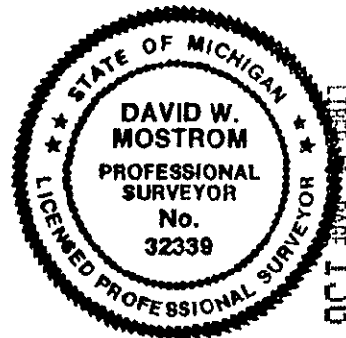

Signed by J. W. Mostrom

Date MAY 10, 1995

Surveyor's Michigan License No. 32339

FORM APPROVED BY MICHIGAN STATE BOARD OF PROFESSIONAL SURVEYORS, JAN. 26, 1971  
REVISED MAY 14, 1975  
REVISED JAN, 1983

# REMONUMENTATION