

SURVEY &
REMONUMENTATION

JAN 22 1999

SECTION

LAND CORNER RECORDATION CERTIFICATE
Filing Requirement of Act 74, Mich. P.A. 1971

For Corners in

ST. JOSEPH (County)
1. Public Land Survey Located In: T 7S R 9W Corner Code # J-2
2. Property Controlling S T R in Section S T R
3. Miscellaneous S T R Property in Sec. S T R
4. Lot No. Recorded Plat
5. Private Claims

LIBER 5 PAGE 111
STATE OF MICHIGAN
ST. JOSEPH COUNTY
FILED
15 DEC 1998 11:15:57 AM
CYNTHIA L. JARRATT
REGISTER OF DEEDS

Register of Deeds Stamp & Filing Number

I, DONALD C. ANDREWS, in a field survey on JUNE 3, 1998, do hereby certify that under requirements of P.A. 74, Michigan P.A. of 1970, the corner points mentioned in lines 1 and 2 above were in conformance with regulations and rules therefor as required in the current manual of survey instructions of the United States Department of the Interior, Bureau of Land Management or by a decree of a Court of Law and/or that the corners mentioned in lines 3, 4 and 5 above were in conformance with the rules of the Michigan Board of Land Surveyors or by a Decree of a Court of Law; established, re-established, monument, re-monumented, recovered, found as expressed below:

NOTE: Not more than 2 corners, all in the same town and range, may be Recorded on this certificate.


A. Description of original monument and accessories and/or Subsequent restoration:
CO. SURVEYOR RECORD BOOK A, P 158, GARDNER 1867 SET STAKE MIDWAY BETWEEN E1/4 AND W1/4

B. Description of corner evidence found and/or method applied in restoring or reestablishing corner:
FOUND "X" STONE ±2.9' NORTH OF INTERSECTION QUARTERLINES

C: Description of monument for corner and accessories to perpetuate locating the position of the corner:
SET 5/8" IRON X 24 INCHES WITH STANDARD REMON. CAP IN PLACE OF "+" STONE

ANCHOR POST NORTH 2.34'
20" HICKORY S 85°E 19.07'
14" BEECH SOUTH 20.13'
24" BEECH WEST 25.21'

RATIFIED BY PEER GROUP
IN ACCORDANCE WITH P.A. 345
ON JUNE 8, 1998
W.C. CO. REPRESENTATIVE

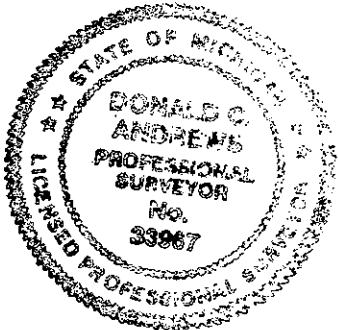

Signed by [Signature] Date 10/28/98
Surveyors Michigan License No. 33967