

SURVEY &  
REMONUMENTATION

JUL 16 1998

SECTION

LAND CORNER RECORDATION CERTIFICATE  
Filing Requirement of Act 74, Mich. P.A. 1970

For corners in

ST. JOSEPH

(County)

Located In:

Corner Code #

MOTTVILLE TWP.  
1. Public Land Survey

T8S R12W

G-2

T R

T R

LIBER 5 PAGE 58

STATE OF MICHIGAN  
ST. JOSEPH COUNTY  
FILED

15 Apr 1998 3:31:28 PM

CYNTHIA L. JARRATT  
REGISTER OF DEEDS

Register of Deeds Stamp & File Number

4. Lot No. \_\_\_\_\_, Recorded Plat \_\_\_\_\_  
5. Private Claims \_\_\_\_\_

I, DAVID W. MOSTROM, in a field survey on APRIL 10, 1998 do hereby state that under requirements of P.A. 74, Michigan P.A. of 1970, the corner points mentioned in lines 1 and 2 above were in conformance with regulations and rules therefore as required in the current manual of survey instructions of the United States Department of the Interior, Bureau of Land Management or by a decree of a Court of Law and/or that the corner points mentioned in lines 3, 4 and 5 above were in conformance with the rules of the Michigan Board of Land Surveyors or by a Decree of a Court of Law; established, re-established, monumented, recovered, found as expressed below:

NOTE: Not more than 2 corners, all in the same town and range, may be recorded on this certificate.

A. Description of original monument and accessories and/or subsequent restoration:

(G-2) 1/4 CORNER COMMON TO SECTIONS 3 & 4 T8S, R12W  
\*1864 SURVEY IN BOOK A, PG. 47 \*1965 ROAD COMMISSION  
STONE FROM ORIGINAL BEARINGS POINTED STONE UNDER 1/2" PIPE  
NO WITNESSES GIVEN 21" BLACK OAK  $\pm$  N19°W 81.23'  
\*1916 SURVEY IN BOOK B, PG. 496 ANCHOR POST = EAST 29.14'  
CORNER USED BUT NOT LABELED 24" CHERRY = S16°W 97.43'  
OR WITNESSED 6" HICKORY = N87°W 28.44'

\*1972 SAYERS SURVEY  
21" BURR OAK = N19°W 81.23'  
6" HICKORY = WEST 28.44'  
\*1983 LCRC IN BOOK 2, PG. 167  
FOUND 1/2" PIPE  
NAIL/CAP IN P. POLE=S15°W 134.22'  
NAIL/CAP IN 10" HICKORY=N86°W 28.4  
NAIL/CAP IN P. POLE=N14°W 136.20'


B. Description of corner evidence found and/or method applied in restoring or reestablishing corner:

(G-2)  
FOUND CAPPED IRON #33967 OVER A POINTED STONE 17" DEEP IN MON. BOX  
CORNER FALLS IN THE CENTERLINE OF BURKE RD. & IN THE PROJECTION OF THE FENCELINE TO THE WEST  
DBL. HEAD NAIL W/CAP #12022 IN SE SIDE OF P. POLE = S20°W 134.15'  
DBL. HEAD NAIL W/CAP #12022 IN NE SIDE OF P. POLE = N08°W 136.17'  
SET 5/8" X 12 IRON BAR W/STD. CAP OVER STONE IN MON. BOX

RATIFIED BY PEER GROUP  
IN ACCORDANCE WITH P.A. 345  
ON April 13, 1998  
CO. REPRESENTATIVE

C. Description of monument for corner and accessories established to perpetuate locating the position of the corner:

(G-2)  
5/8" X 12" IRON BAR W /STD. CAP OVER STONE IN MON. BOX  
1/2" IRON BAR = N45°E 23.84'  
1/2" IRON BAR = S45°E 19.65'  
N & W 1.5' HIGH ON N. SIDE OF 16" HICKORY = WEST 48.23'  
DBL. HEAD NAIL W/CAP #12022 0.5' HIGH IN SE SIDE OF P. POLE = S20°W 134.15'  
DBL. HEAD NAIL W/CAP #12022 1.0' HIGH IN NE SIDE OF P. POLE = N08°W 136.17'

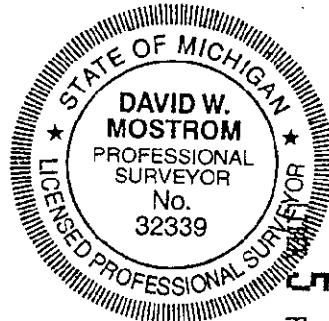

Signed by DAVID W. MOSTROM

Date APRIL 14, 1998

Surveyor's Michigan License No. 32339