

LAND CORNER RECORDATION CERTIFICATE
Filing Requirement of Act 74, Mich. P.A. 1970

For corners in

Schoolcraft

(County)

Located In:

Corner Code #

1. Public Land Survey

T___ R___
T___ R___
T___ R___
T___ R___

2. Property Controlling
in Section

S 31 T 41N R 17W
S 16 T 41N R 17W

3
2

3. Miscellaneous
Property in Sec.

S___ T___ R___
S___ T___ R___

Register of Deeds Stamp & File Number

4. Lot No. _____, Recorded Plat _____
5. Private Claims _____

2 May 01 2003
3 Jun 03 2003

I, Stephan J. Szyszkoski, in a field survey on _____, 20____ do hereby state that under requirements of P.A. 74, Michigan P.A. of 1970, the corner points mentioned in lines 1 and 2 above were in conformance with regulations and rules therefore as required in the current manual of survey instructions of the United States Department of the Interior, Bureau of Land Management or by a decree of a Court of Law and /or that the corner points mentioned in lines 3, 4 and 5 above were in conformance with the rules of the Michigan Board of Land Surveyors or by a Decree of a Court of Law; established, re-established, monumented, recovered, found as expressed below:

NOTE: Not more than 2 corners, all in the same town and range, may be recorded on this certificate.

	A	B	C	D	E	F	G	H	I	J	K	L	M
1													
2		6		5		4		3		2		1	
3													
4		7		8		9		10		11		12	
5													
6		18		17		16		15		14		13	
7													
8		19		20		21		22		23		24	
9													
10		30		29		28		27		26		25	
11													
12		31		32		33		34		35		36	
13													

A. Description of original monument and accessories and/or subsequent restoration:

(3-Sec. 31) North 1/16 corner between Sections 31 T41N-R17W and 36 T41N-R18W. Not established in the original survey. Found no subsequent record.

(2-Sec. 16) East 1/16 corner between Sections 9 and 16. Not established in the original survey.

B. Description of corner evidence found and/or method applied in restoring or reestablishing corner:

(3-Sec. 31) Found a 5/8" dia. rebar 0.04' N and 0.04' E of the midpoint between Section and Quarter corners north and south and accepted same. The corner lies approximately 15' east of a road.

(2-Sec. 16) Established the corner midway and on a line of mean true bearing between Section corner 1325.82 ft. east and Quarter corner 1325.82' west.

C. Description of monument for corner and accessories established to perpetuate locating the position of the corner:

(3) Set plastic cap "MICH DNR PS 33986" on found 5/8" dia. rebar. Blazed, scribed, and set measuring nails in:


5" Balsam S42E 15.65' "N1/16 8T"
5" Balsam S12W 17.75' do
6" Cedar S31E 52.8' do
10" W.Birch S82W 71.4' do

Bearings are magnetic. Distances are to nail with tag.

(2) Set 5/8"x24" rebar with plastic cap "MICH DNR PS 33986". Placed nails with plastic ID tags in:

8" Maple S63W 65.9'
6" Maple S38W 42.6'
6" Elm S37E 44.05'
6" Maple N11E 41.4'

Center of road is North 2.0'
Bearings are magnetic. Distances are horizontal and to nail with tag in the side of 8T.

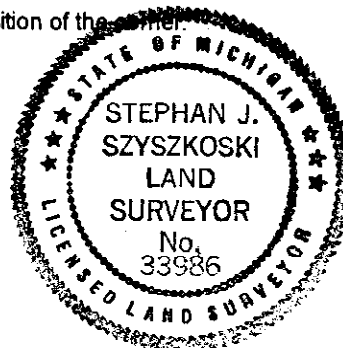

Signed by Stephan J. Szyszkoski

Date

6/16/03

Surveyor's Michigan License No. 33986

For the Michigan Department of Natural Resources - Office of Land and Facilities

FORM APPROVED BY MICHIGAN STATE BOARD OF PROFESSIONAL SURVEYORS, JAN. 28, 1971

REVISED MAY 14, 1975

REVISED JAN., 1983

REVISED OCT., 1995