

SCHOOLCRAFT COUNTY
PEER GROUP APPROVED

DATE 10/15/97

LAND CORNER RECORDATION CERTIFICATE
Filing Requirement of Act 74, Mich. P.A. 1970

SURVEY &
REMONUMENTATION

JAN 21 1998

For corners in

Schoolcraft
(County)

Located In:

Corner Code #

SECTION

1. Public Land Survey

T42NR16W

J-7

2. Property Controlling
in Section

S

T

3. Miscellaneous
Property in Sec.

S

T

4. Lot No. , Recorded Plat

5. Private Claims

Received & Filed this 9 day of
December 1997 at 3:52 PM
Sigrid I. Hedberg
Schoolcraft Co. Reg. of Deeds

Register of Deeds Stamp & File Number

I, Thomas P. O'Brien, in a field survey on Nov. 5, 1997 do hereby state that under requirements of P.A. 74, Michigan P.A. of 1970, the corner points mentioned in lines 1 and 2 above were in conformance with regulations and rules therefore as required in the current manual of survey instructions of the United States Department of the Interior, Bureau of Land Management or by a decree of a Court of Law and/or that the corner points mentioned in lines 3, 4 and 5 above were in conformance with the rules of the Michigan Board of Land Surveyors or by a Decree of a Court of Law; established, re-established, monumented, recovered, found as expressed below:

NOTE: Not more than 2 corners, all in the same town and range, may be recorded on this certificate.

	A	B	C	D	E	F	G	H	I	J	K	L	M
1													
2		6		5		4		3		2		1	
3													
4		7		8		9		10		11		12	
5													
6		18		17		16		15		14		13	
7													
8		19		20		21		22		23		24	
9													
10		30		29		28		27		26		25	
11													
12		31		32		33		34		35		36	
13													

A. Description of original monument and accessories and/or subsequent restoration:

J-7 N 1/4 Corner Section 23

Aug. 14, 1850 - Algernon Merryweather D.S. set qr. section post.
Beech 7 S30W 8 lks. Sugar 8 N53E 5 lks.

Sept. 19, 1985 - Neil E. Hill L.S. "Found 1" iron pin in Monument Box at location of record, from M.D.O.T. records: Corner related to M-94 alignment. Witnessed to preserve location prior to construction.

Sept. 6, 1988 - Neil E. Hill L.S. "Re-set corner with 1/2" Re-rod and cap #27447 in Monument Box. LCRC recorded Liber 2, page 198.


B. Description of corner evidence found and/or method applied in restoring or reestablishing corner:

J-7 Nov. 5, 1997 - Thomas P. O'Brien P.S. recovered 1/2" Re-rod with cap #27447 in monument box as set by Neil E. Hill on Sept 6, 1988. Witnesses found verify corner location.

C. Description of monument for corner and accessories established to perpetuate locating the position of the corner:

J-7 1/2" Re-rod with cap #27447 in monument box.

Witnesses: (Fd.) T. Pole - N58°E - 61.43'
(Fd.) P. Pole - S50°W - 61.57' (Poor cond.)
NBT. 12" W. Pine - S37°E - 111.10'
NBT. 8" Cedar - S42°W - 93.78'
NBT. 10" R. Pine - N49°W - 81.89'
4" Cedar Post - East - 50.0'

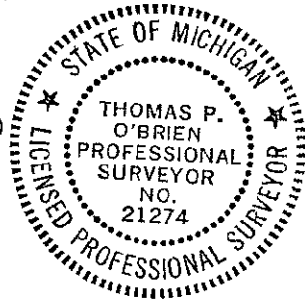

Signed by Thomas P. O'Brien P.S.

Date November 26, 1997

Surveyor's Michigan License No. 21274

LIBER 4 PAGE: 133