

SCHOOLCRAFT COUNTY
PEER GROUP APPROVED

SURVEY &
REMONUMENTATION

JAN 21 1998

DATE 10/15/97

LAND CORNER RECORDATION CERTIFICATE
Filing Requirement of Act 74, Mich. P.A. 1970

SECTION

For corners in

Schoolcraft
(County)

Located In:

Corner Code #

1. Public Land Survey

T42N R16W

L-11

T R

T R

T R

2. Property Controlling
in Section

S

T R

S

T R

3. Miscellaneous
Property in Sec.

S

T R

S

T R

Received & Filed this 23 day of
Dec 1997 at 3:09 P M
Sigrid J. Hedberg
Schoolcraft Co. Reg. of Deeds

Register of Deeds Stamp & File Number

4. Lot No. , Recorded Plat

5. Private Claims

I, Thomas P. O'Brien, in a field survey on Dec. 8, 1997 do hereby state that under requirements of P.A. 74, Michigan P.A. of 1970, the corner points mentioned in lines 1 and 2 above were in conformance with regulations and rules therefore as required in the current manual of survey instructions of the United States Department of the Interior, Bureau of Land Management or by a decree of a Court of Law and/or that the corner points mentioned in lines 3, 4 and 5 above were in conformance with the rules of the Michigan Board of Land Surveyors or by a Decree of a Court of Law; established, re-established, monumented, recovered, found as expressed below:

NOTE: Not more than 2 corners, all in the same town and range, may be recorded on this certificate.

	A	B	C	D	E	F	G	H	I	J	K	L	M
1													
2		6		5		4		3		2		1	
3													
4		7		8		9		10		11		12	
5													
6		18		17		16		15		14		13	
7													
8		19		20		21		22		23		24	
9													
10		30		29		28		27		26		25	
11													
12		31		32		33		34		35		36	
13													

A. Description of original monument and accessories and/or subsequent restoration:

L-11 North 1/4 Corner Section 36

Aug. 8, 1850 - Algernon Merryweather D.S. set qr. section post.

Cedar 8 in. East 60 links Do. 10 in. S75E 75 links

March 15, 1988 - Gerald L. Wiggins R.L.S. " 1/4 Corner computed by single proportionate measure. Set witness corner 55.0' East. 1/4 Corner falls in Bayou which fits original measurement."


B. Description of corner evidence found and/or method applied in restoring or reestablishing corner:

L-11 Dec. 8, 1997 - Thomas P. O'Brien P.S. recovered a 1" iron pipe with 4" aluminum DNR cap stamped to identify as set by Gerald L. Wiggins R.L.S. on March 15, 1988. Witnesses found verify corner as witness corner to 1/4 corner which falls in bayou.

C. Description of monument for corner and accessories established to perpetuate locating the position of the corner:

L-11 1" iron pipe with 4" aluminum DNR cap stamped to identify.

Witnesses: 5" Cedar - S50°E - 3.90'
5" Cedar - N81°W - 6.00'
5" Cedar - N32°W - 7.20'
4" Cedar - North - 19.60'
Carsonite Post - North - 2.0'

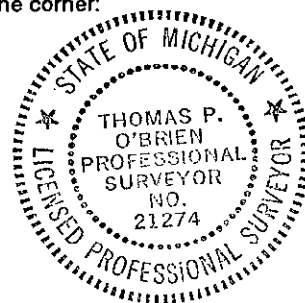

Signed by Thomas P. O'Brien P.S.

Date December 19, 1997

Surveyor's Michigan License No. 21274

LIBER 4 PAGE 155