

LAND CORNER RECORDATION CERTIFICATE
 Filing Requirement of Act 74, Mich. P.A. 1970 as Amended

For corners in

Schoolcraft	Located In:	Corner Code #
(County)		
1. Public Land Survey	T 43N R 15W	E7
	T _____ R _____	_____
	T _____ R _____	_____
2. Property Controlling in Section	S T _____ R _____	_____
	S 21 T 43N R 15W	13
	S _____ T _____ R _____	_____
3. Miscellaneous Property in Sec.	S T _____ R _____	_____
	S _____ T _____ R _____	_____
4. Lot No. _____, Recorded Plat _____		
5. Private Claims _____		

Register of Deeds Stamp & File Number

1	A	B	C	D	E	F	G	H	I	J	K	L	M
2	6	5	4	3	2	1							
3													
4	7	8	9	10	11	12							
5													
6	18	17	16	15	14	13							
7													
8	19	20	21	22	23	24							
9													
10	30	29	28	27	26	25							
11													
12	31	32	33	34	35	36							
13													

I, Stephan J. Szyszkoski, in a field survey on 13 02/08/2011 do hereby state that under requirements of P.A. 74, Michigan P.A. of 1970, the corner points mentioned in lines 1 and 2 above were in conformance with regulations and rules therefore as required in the current manual of survey instructions of the United States Department of the Interior, Bureau of Land Management or by a decree of a Court of Law and /or that the corner points mentioned in lines 3, 4 and 5 above were in conformance with the rules of the Michigan Board of Land Surveyors or by a Decree of a Court of Law; established, re-established, monumented, recovered, found as expressed below:

NOTE: Not more than 2 corners, all in the same town and range, may be recorded on this certificate.

A. Description of original monument and accessories and/or subsequent restoration:

(E7) Corner common to Sections 16-17-20-21. 1973 - Reestablished by F.J.Bray RLS by proportionate measurement. Set 1"ID I.pipe with 4" alum. cap. 6" Cedar N52E 11.2', 5" Cedar S60W 8.4'.

(13-Sec. 21) Southeast 1/16 corner, Section 21. Not established in the original survey.

B. Description of corner evidence found and/or method applied in restoring or reestablishing corner:

(E7) Found the 1973 monument in good condition and at record bearing and distance from the 1973 witnesses. The Cedar NE is now dead. The Cedar SW is in good condition. Accepted the monument as a careful and faithful reestablishment of the position of the original corner.

(13-Sec. 21) Established the corner at the intersection of straight lines connecting opposite 1/16 corners.


C. Description of monument for corner and accessories established to perpetuate locating the position of the corner:

(E7) Fd. 1" ID I.pipe with 4" aluminum cap. Set measuring nail with MDNR tag in the side of:
 8" Cedar S59W 8.7' mrkd "S20" 1973 NBT
 10" Cedar N37E 8.8' mrkd "S16 NBT"
 10" B.Spruce S52E 15.1' "S21 NBT"
 8" Cedar N72W 14.15' "S17 NBT"
 Bearings are magnetic.

(13) Set 1"IDx36" I.pipe with 4" alum. MDNR cap. Set measuring nail with MDNR tag in the side of:
 15" W.Pine S13W 11.1' mrkd "SE1/16 BT"
 8" R.Pine S60E 28.05' do
 8" B.Spruce N15E 15.3' do
 8" Cedar S61W 22.7' do
 Bearings are magnetic.

Signed by Stephan J. Szyszkoski
 Surveyor's Michigan License No. 33986

Date 03/08/2011

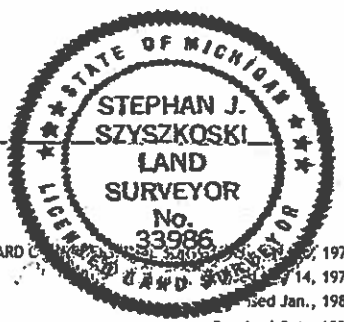

For the Michigan Department of Natural Resources, Office of Land and Facilities

47460
47459