

LAND CORNER RECORDATION CERTIFICATE
Filing Requirement of Act 74, Mich. P.A. 1970 as Amended

For corners in

Schoolcraft (County)	Located In:	Corner Code #
1. Public Land Survey	T R	
	T R	
	T R	
2. Property Controlling in Section	S 33 T 46N R 13W	8
	S 33 T 46N R 13W	3
	S T R	
3. Miscellaneous Property in Sec.	S T R	
	S T R	
4. Lot No. , Recorded Plat		
5. Private Claims		

Register of Deeds Stamp & File Number

1	A	B	C	D	E	F	G	H	I	J	K	L	M
2	6	5	4	3	2	1							
3													
4	7	8	9	10	11	12							
5													
6	18	17	16	15	14	13							
7													
8	19	20	21	22	23	24							
9													
10	30	29	28	27	26	25							
11													
12	31	32	33	34	35	36							
13													

I, Stephan J. Szyszkoski, in a field survey on 8 03/16/2011 do hereby state
that under requirements of P.A. 74, Michigan P.A. of 1970, the corner points mentioned in lines 1 and 2
above were in conformance with regulations and rules therefore as required in the current manual of survey
instructions of the United States Department of the Interior, Bureau of Land Management or by a decree of
a Court of Law and /or that the corner points mentioned in lines 3, 4 and 5 above were in conformance with
the rules of the Michigan Board of Land Surveyors or by a Decree of a Court of Law; established,
re-established, monumented, recovered, found as expressed below:

NOTE: Not more than 2 corners, all in the same town and range, may be recorded
on this certificate.

A. Description of original monument and accessories and/or subsequent restoration:

(8-Sec. 33) West 1/16 corner, Section 33. 1991 - Thomas P. O'Brien PS 21274 states in LCR L.2, P.324
that this corner was "set by section subdivision". Set 1/2" I.B. 6" R.Pine N12E 73.9', Power Pole
S60E 43.4'.

(3-Sec. 33) North 1/16 corner between Sections 32 and 33. Found no record of prior monumentation.

B. Description of corner evidence found and/or method applied in restoring or reestablishing corner:

(8-Sec. 33) Found the 1991 monument in good condition and at record bearing and distance from the two
1991 witnesses. The monument does not occupy the proper position for the 1/16 corner, it being
located N88 deg. 34'03"E 17.58' (MCS83 grid bearing) from a position midway and on a straight line
between Quarter corner E12 and Center of Section F12. I did not accept the 1991 monument and
established the corner midway and on a straight line between E12 and F12, 1338.63' west and east.

(3-Sec. 33) Established the corner midway and on the Section line between Section corner E11 1309.52'
north and Quarter corner E12 1309.52' south. The position for the corner falls in a wet cattail
marsh.

C. Description of monument for corner and accessories established to perpetuate locating the position of the corner:


(8) Set 1"IDx32" I.pipe with 4" alum. MDNR cap.
Nail and tag in the following:
7" R.Pine N27E 78.4' old blaze (1991 BT)
6" Tamarack N61W 11.85' mrkd "W1/16 BT"
7" W.Pine N75E 32.55' do
P.pole 'M898' S67E 59.8'
1/2" capped rebar, flush, East 17.58'
Bearings are magnetic.

(3) Set 1"IDx32" I.pipe with 4" alum. MDNR cap.
Set measuring nail with MDNR tag in the side of:
5" Maple N27E 46.05' mrkd "N1/16 BT"
9" Maple N75E 30.0' do
3" Maple N53W 19.8'
Nail in Tag Alder stump S28E 19.4'
Bearings are magnetic.

Signed by Stephan J. Szyszkoski
Surveyor's Michigan License No. 33986

Date 12/28/2011

For the Michigan Department of Natural Resources, Forest Management Division

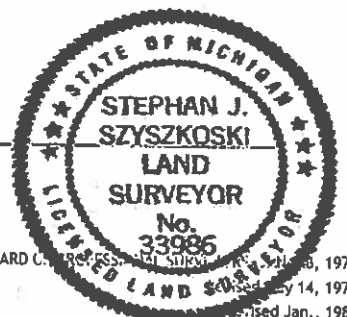

47489

47490